

ADDENDUM NO. 1

DATED

JULY 24, 2020

NATICK, MASSACHUSETTS
BOARD OF SELECTMEN

CONTRACT NO. S-162

3 YEAR SEWER REHABILITATION PROJECT

TO ALL BIDDERS OF RECORD:

This Addendum shall be part of the Contract Documents as provided in the Instructions to Bidders of Contract No. S-162. Acknowledgment of receipt of the Addendum shall be made by inserting its number on Page 00300-1 of the Bid Form. Failure to do so may subject the bidder to disqualification.

All available CCTV inspection reports and SMH inspection reports for the Known work items are available for review from the Engineer. Requests to access the inspection information should be in writing to aford@cesincusa.com. Per Paragraph 9 of the Instructions to Bidders (Section 00100), all such information is furnished only for the information and convenience of Bidders and is not guaranteed.

TABLE OF CONTENTS/APPENDIX

INSERT “Sewer Flow Data” at the end of the Appendix contents list, and **INSERT** the attached section entitled “Sewer Flow Data” (9 pages total) at the end of the Appendix.

TABLE OF CONTENTS/APPENDIX

INSERT “Table 4 - Point Repairs and Replacement Scope of Work” following “Table 3” in the Appendix contents list, and **INSERT** the attached Table 4 (1 page) after Table 3 in the Appendix.

Section 00300 – Bid, page 00300-9

In Item 29, Rehabilitation of Manhole, Known and Unknown Work, **DELETE** “and Unknown”

Section 00300 – Bid, page 00300-12

In Item 42, Remove and Replace Existing Sewer (8-Inch Through 12-Inch; 0-8 Feet Deep)
Beyond 10 Linear Feet, **DELETE** the estimated quantity of “200” and **INSERT** “600” in its place.

Section 00300 – Bid, page 00300-15

DELETE Item 56 and **INSERT** the following:

56. For Police Details, the Fixed Lump Sum price of

_____ Seventy-five Thousand Dollars _____ = \$ 75,000.00
(Fixed Lump Sum Price in Words)

Section 00300 – Bid, page 00300-15

INSERT the following after Item 58:

59. For Grinding Protruding Service Connections the unit price of

_____ (Unit Price in Words)
150 EA. x \$ _____ = \$ _____
(Unit Price in Figures)

DELETE page 00300-15 and **INSERT** the attached page 00300-15 in its place

01010 Scope of Work

DELETE Section 01010 in its entirety and **INSERT** the attached Section 01010 in its place.

01025 Measurement and Payment, page 01025-21

INSERT the following after paragraph 1.42(B.)(1.):

2. Payment for Police Details on Rte 9 related work shall be paid under Item 56.

01025 Measurement and Payment, page 01025-22

INSERT the following after paragraph 1.43(B.)(1.):

1.44 GRINDING PROTRUDING SERVICE CONNECTIONS (Item 59)

A. Measurement

1. Measurement for grinding protruding service connections shall be per each, based on the actual number of protruding service connections ground down where required for mainline and lateral CIPP liner installations.

B. Payment

1. Payment for grinding protruding service connections shall be at the unit price bid per each under Item No. 59. This price shall be full compensation for locating and grinding down protruding service connections with traditional rotary cutters or lateral reinstatement cutters if necessary, and all

- labor, materials, tools and equipment necessary for a first class installation as specified herein or reasonably implied.
2. Only services protruding 1/2-inch or more into the mainline will qualify for payment under this item.
 3. All costs related to disposal of cleaning debris shall be paid for under Bid Item No. 7.

02774 Cured-in-Place Lateral Rehabilitation, page 02774-3

DELETE paragraph 2.1(B)(2) in its entirety and **INSERT** the following in its place:

2. The minimum length shall be 24 inches (2 feet) to effectively span the distance from the lateral connection at the main or to the desired termination location in the service lateral pipe, up to a maximum distance of 25 feet from the main. Lateral lining will be accomplished without a cleanout whenever possible. In the event a cleanout is required to complete the lining of the lateral, the Contractor shall notify the Engineer and a determination shall be made whether to install a cleanout or reduce the length of lining installed to the maximum possible without use of a cleanout. When required, an overlap method is performed with a pull-in-process installation from a cleanout or access point back to the main. In either case, the lateral liner must provide a watertight seal at the mainline and a structural repair of the lateral over the specified length. The Installer shall verify the lengths in the field before impregnation of the resin.

02763 Sewer Line Cleaning, page 02763-3

DELETE “the designated” from the first line of paragraph 3.4(A.) and **INSERT** “any” in its place.

02763 Sewer Line Cleaning, page 02763-3

INSERT the following new paragraph after paragraph 3.4:

3.5 CHAIN KNOCKING

- A. Excessive tuberculation in cast iron sewer mains shall be removed prior to further rehabilitation work. The Contractor shall provide mechanical cleaning equipment that is specifically designed and constructed for this purpose (chain-knockers). Appropriate spacers/spiders for the size pipe being cleaned shall be used to center the chain knocking equipment within the pipe.
- B. The Engineer shall be present when any chain-knocking work is completed.

APPENDIX – Scope of Work Tables

In the Table entitled “Manhole Rehabilitation Scope of Work (Inflow Removal Related)”,
DELETE the title “Table 3” and **INSERT** the title “Table 2” in its place.

APPENDIX – Sewer Basin Maps for Rehabilitation

DELETE all Basin Maps and **INSERT** the attached set of revised Basin Maps (20 pages total)

APPENDIX – Natick Sewer Record Drawings

INSERT the attached set of Town Sewer Record Drawings following the Sewer Basin Maps (14 pages total)

<u>ITEM NO.</u>	<u>DESCRIPTION</u>	<u>AMOUNT</u>
---------------------	--------------------	---------------

56. For Police Details , the Fixed Lump Sum price of

Seventy-five Thousand Dollars = \$ 75,000.00
(Fixed Lump Sum Price in Words)

57. For Traffic Management (Rte. 9 related work), the Lump Sum price of

(Lump Sum Price in Words) = \$ _____

58. For Sewer Bypass System for Lining of MH Segment 4-7 to 4-6, the Lump Sum price of

(Lump Sum price in Words) _____ = \$ _____

59. For Grinding Protruding Service Connections the unit price of

Per each for an estimated quantity of

150 EA. x \$ _____ = \$ _____
(Unit Price in Figures)

TOTAL BASE BID PRICE FOR BID COMPARISON = \$

(Bid Price in Words)

An unbalanced or unreasonable lump sum price submitted herein may be grounds for rejection of the Bid.

Specific items of this Contract may be eliminated or reduced in quantity to keep within limits of available funding, at the OWNER'S option.

STATEMENT OF EXPERIENCE: The undersigned as Bidder declares that he has successfully accomplished similar sewer rehabilitation work in the following places:

1. Description of Project

completion, etc.)

Owner & Contact Person _____
(Names, Addresses and Telephone Nos.)

NAT-427/Contract No. S-162
Addendum No. 17/24/2020

BID

BID
00300-15

SECTION 01010

SUMMARY OF THE WORK

PART 1 - GENERAL

1.1 DESCRIPTION

A. Work included:

1. The "Known" Work of this Contract will be as shown on the drawings, identified in the appendix and outlined in the specifications and will be authorized by the OWNER based on available funds. Work areas will be located throughout the Town of Natick, Massachusetts on Town property and easements.
2. The "Unknown" Work of this Contract will be as authorized by the OWNER. "Unknown" Work is any work authorized by the OWNER that is not included on the Contract Drawings or in the appendix section of the Contract Documents.
3. The sewer main rehabilitation work (Table 3 in the Appendix) shall include, but not necessarily be limited to providing all labor, materials, equipment and incidentals required to provide the following:
 - a. Relining of gravity sewer mains with a cured-in-place (CIPP) liner.
 - b. Service lateral CIPP lining.
 - c. Service chimney CIPP lining.
 - d. CIPP lining point repairs.
 - e. Test and seal of pipe line joints.
 - f. Testing and sealing of service laterals.
 - g. Pre- and post-rehabilitation cleaning and CCTV inspection of sewer main segments and service laterals to be rehabilitated, whether by CIPP lining, test and sealing, or replacement through excavation.
 - h. All costs shall be included in the various rehabilitation pay items, with the exception of heavy cleaning or chain-knocking, if required.
 - i. Pre-CCTV inspections indicating conditions requiring a change in the scope of work on that segment shall be brought to the attention of the Engineer for determination of appropriate rehabilitation work.
 - j. Root treatment beyond hydraulic and mechanical cleaning efforts described in Section 02763, if necessary, will be considered an extra cost, and must be approved by the OWNER.
 - k. Additional sewer lining cleaning and CCTV inspection where authorized by the OWNER (investigative work).
 - l. Pre-rehabilitation mainline cleaning and CCTV inspection completed under paragraph 3.g. above, where the rehabilitation cannot be completed shall be paid for under this item.

- m. Successful Bidder shall provide wastewater by-pass pumping around main line segments to be rehabilitated, if pipe size and flows require such.
 - n. Successful Bidder shall provide wastewater by-pass pumping for all high use services during lining process. All costs for by-passing high use services shall be submitted for approval as an extra cost.
 - o. Successful Bidder shall be required to clean and televise all lines prior to relining, make all required measurements, confirm location of all active services, by-pass pumping of all mains requiring relining and preparing pre and post lining video and written logs.
 - p. Furnishing and utilizing all confined space entry equipment required by State and Federal laws and legal bylaws.
 - q. Successful Bidder shall also prepare pre and post video logs in DVD format capable of viewing on free software.
 - r. Successful Bidder shall conduct one (1) year warranty internal television inspections as required within these Specifications. Any defects identified shall be repaired at the Successful Bidder's expense. Defects include, but are not limited to, infiltration leaks and sagging liner.
4. The sewer main excavated point repairs and replacement work (Table 4 in the Appendix) shall include, but not necessarily be limited to providing all labor, materials, equipment and incidentals required to provide the following:
- a. Sewer point repairs (up to 10 LF length) at ± 7 known locations, varying in depth between 6 and 9 feet.
 - b. Sewer service chimney repairs at ± 11 known locations, varying in depth between 10 and 23 feet. Most locations may have a double-wye connection at the top of the chimney.
 - c. Sewer replacement (> 10 LF in length) at ± 5 known locations; total estimated length of 103 lf and maximum depth of 8 feet.
 - d. Installation of a new sewer manhole at the intersection of N. Main St and Mechanic St. (Sewer Basin 9). Mechanic St. sewer currently ties in with a T-connection.
 - e. Installation of two new sewer manholes and approximately 470 LF of 8-inch PVC sewer from SMH 11-322 on Westview Ave. to a point 167 ft. downstream of SMH 11-14, and reconnection of ± 6 service connections. Sewer depth is less than 8-ft.
5. The manhole rehabilitation work (Tables 1 and 2 in the Appendix) shall include, but not necessarily be limited to providing all labor, materials, equipment and incidentals required to provide the following where directed.
- a. Pressure wash all interior surfaces of manholes prior to rehabilitation work.
 - b. Rehabilitation of sewer manhole walls, tables and invert through injection grouting to seal active leaks, structural repairs and/or coating of the interior of the manhole.
 - c. Furnishing and Installing new manhole frames and covers.
 - d. Install manhole frame inserts for inflow removal.
 - e. Build/repair manhole bench and invert.
 - f. Repair corbel (both brick and pre-cast).

- g. Reset manhole frame and covers.
- h. Repair non-leaking manhole defects.
- i. Replace and/or repair brick and mortar.
- j. Redirection/bypass of wastewater flow in manhole to downstream manhole to facilitate rehabilitation work, when required.
- k. Furnishing and utilizing all confined space entry equipment required by State and Federal laws and legal bylaws.
- l. Preparation of repair report identifying leaks, estimated quantity of leak, and work and materials utilized in completing rehabilitation work.
- m. Successful Bidder shall conduct one (1) year warranty inspection of completed rehabilitated manholes for defects. Any defects in the material used in the rehabilitation process identified shall be repaired at the Successful Bidder's expense. Defects include, but not limited to groundwater leaks through manhole walls and delaminating coatings.

B. Known Work Group Included:

- 1. The known work of this Contract is identified on the Contract Drawings and in the tables found in the appendix.
- 2. The appendix outlines the anticipated type of work associated with an asset.
 - a. "Repair non-leaking" means that a repair is anticipated to be made on that particular aspect of the manhole.
 - b. Repair leaking means that chemical injection AND a physical repair is anticipated on that particular aspect of the manhole.

C. Unknown Work Groups

- 1. Owner or Engineer will notify the Successful Bidder with a written authorization to complete a Work Group. Each Work Group could include any combination of sewer main lining, sewer main/service point repairs, sewer main investigative inspection, or manhole rehabilitation.

END OF SECTION

Summary Flow Report

Site:

3-3

57 Oak Street

Natick, MA

Sewer Flow Data
Addendum No. 1
Contract S-162



9.5" Circular Line

Date	Minimum Flow (mgd)	Peak Flow (mgd)	Total Daily Flow (mg)	Total Rain (in)	Peak Hourly Rain (in)	Peak Interval Rain (in)
3/26/2018 (Mon)				0.01	0.01	0.01
3/27/2018 (Tue)	0.039	0.415	0.136	0.00	0.00	0.00
3/28/2018 (Wed)	0.033	0.426	0.180	0.01	0.01	0.01
3/29/2018 (Thu)	0.027	0.440	0.167	0.02	0.02	0.01
3/30/2018 (Fri)	0.019	0.390	0.171	0.07	0.05	0.02
3/31/2018 (Sat)	0.021	0.452	0.182	0.00	0.00	0.00
4/1/2018 (Sun)	0.008	0.503	0.156	0.00	0.00	0.00
4/2/2018 (Mon)	0.019	0.431	0.146	0.14	0.14	0.02
4/3/2018 (Tue)	0.017	0.512	0.143	0.47	0.14	0.02
4/4/2018 (Wed)	0.022	0.348	0.133	0.21	0.11	0.02
4/5/2018 (Thu)	0.022	0.353	0.137	0.00	0.00	0.00
4/6/2018 (Fri)	0.019	0.361	0.147	0.29	0.07	0.01
4/7/2018 (Sat)	0.020	0.421	0.167	0.03	0.02	0.01
4/8/2018 (Sun)	0.020	0.384	0.165	0.00	0.00	0.00
4/9/2018 (Mon)	0.008	0.440	0.144	0.00	0.00	0.00
4/10/2018 (Tue)	0.011	0.326	0.123	0.00	0.00	0.00
4/11/2018 (Wed)	0.008	0.369	0.136	0.00	0.00	0.00
4/12/2018 (Thu)	0.011	0.384	0.134	0.07	0.07	0.01
4/13/2018 (Fri)	0.011	0.381	0.133	0.00	0.00	0.00
4/14/2018 (Sat)	0.007	0.504	0.129	0.00	0.00	0.00
4/15/2018 (Sun)	0.013	0.317	0.124	0.13	0.05	0.01
4/16/2018 (Mon)	0.008	0.454	0.180	1.84	0.37	0.07
4/17/2018 (Tue)	0.063	0.427	0.213	0.00	0.00	0.00
4/18/2018 (Wed)	0.048	0.381	0.176	0.00	0.00	0.00
4/19/2018 (Thu)	0.039	0.316	0.150	0.22	0.07	0.01
4/20/2018 (Fri)	0.033	0.402	0.163	0.00	0.00	0.00
4/21/2018 (Sat)	0.031	0.407	0.174	0.00	0.00	0.00
4/22/2018 (Sun)	0.027	0.432	0.164	0.00	0.00	0.00
4/23/2018 (Mon)	0.024	0.782	0.157	0.00	0.00	0.00
4/24/2018 (Tue)	0.022	0.387	0.136	0.00	0.00	0.00
4/25/2018 (Wed)	0.021	0.344	0.127	1.25	0.33	0.09
4/26/2018 (Thu)	0.053	0.411	0.170	0.04	0.02	0.01
4/27/2018 (Fri)	0.031	0.356	0.155	0.34	0.19	0.03
4/28/2018 (Sat)	0.033	0.360	0.162	0.00	0.00	0.00
4/29/2018 (Sun)	0.025	0.344	0.137	0.10	0.04	0.03
4/30/2018 (Mon)	0.022	0.317	0.124	0.12	0.04	0.02
Total for period			5.338	5.36		

Min: 0.007
Avg: 0.153
Max: 0.782

Flow measured at SMH 3-3 at inlet to Oak St Pump Station. Oak St PS discharges into SMH 4-13 on Maine Ave., 1200' upstream of SMH 4-7. There are approximately 12 service connections between 4-13 and 4-7, including McDonalds and JoAnn Fabrics

Detailed flow meter data at 15 min. intervals is also available

Summary Flow Report

Site:

3-3

57 Oak Street

Natick, MA



9.5" Circular Line

Date	Minimum Flow (mgd)	Peak Flow (mgd)	Total Daily Flow (mg)	Total Rain (in)	Peak Hourly Rain (in)	Peak Interval Rain (in)
5/1/2018 (Tue)	0.020	0.370	0.136	0.00	0.00	0.00
5/2/2018 (Wed)	0.019	0.344	0.130	0.00	0.00	0.00
5/3/2018 (Thu)	0.016	0.414	0.127	0.01	0.01	0.01
5/4/2018 (Fri)	0.015	0.313	0.117	0.02	0.01	0.01
5/5/2018 (Sat)	0.012	0.366	0.130	0.00	0.00	0.00
5/6/2018 (Sun)	0.013	0.353	0.123	0.36	0.23	0.03
5/7/2018 (Mon)	0.012	0.306	0.119	0.00	0.00	0.00
5/8/2018 (Tue)	0.012	0.301	0.107	0.00	0.00	0.00
5/9/2018 (Wed)	0.004	0.413	0.103	0.00	0.00	0.00
5/10/2018 (Thu)	0.003	0.486	0.108	0.00	0.00	0.00
5/11/2018 (Fri)	0.003	0.514	0.110	0.00	0.00	0.00
5/12/2018 (Sat)	0.003	0.592	0.110	0.22	0.07	0.01
5/13/2018 (Sun)	0.004	0.489	0.120	0.00	0.00	0.00
5/14/2018 (Mon)	0.010	0.414	0.121	0.00	0.00	0.00
5/15/2018 (Tue)	0.006	0.310	0.093	0.83	0.60	0.29
5/16/2018 (Wed)	0.008	0.322	0.110	0.01	0.01	0.01
5/17/2018 (Thu)	0.012	0.388	0.107	0.00	0.00	0.00
5/18/2018 (Fri)	0.008	0.367	0.109	0.00	0.00	0.00
5/19/2018 (Sat)	0.008	0.364	0.100	0.19	0.04	0.01
5/20/2018 (Sun)	0.008	0.375	0.107	0.05	0.03	0.01
5/21/2018 (Mon)	0.007	0.389	0.119	0.00	0.00	0.00
5/22/2018 (Tue)	0.007	0.287	0.088	0.03	0.01	0.01
5/23/2018 (Wed)	0.006	0.384	0.119	0.10	0.10	0.02
5/24/2018 (Thu)	0.011	0.391	0.121	0.00	0.00	0.00
5/25/2018 (Fri)	0.005	0.321	0.108	0.00	0.00	0.00
5/26/2018 (Sat)	0.004	0.360	0.094	0.00	0.00	0.00
5/27/2018 (Sun)	0.004	0.265	0.081	0.08	0.03	0.01
5/28/2018 (Mon)	0.006	0.311	0.092	0.01	0.01	0.01
5/29/2018 (Tue)	0.006	0.316	0.111	0.00	0.00	0.00
5/30/2018 (Wed)	0.010	0.361	0.109	0.00	0.00	0.00
5/31/2018 (Thu)	0.005	0.318	0.103	0.00	0.00	0.00
Total for period			3.432	1.91		
					Min: 0.003	
					Avg: 0.111	
					Max: 0.592	

Summary Flow Report



Site:

3-3

57 Oak Street

Natick, MA

9.5" Circular Line

Date	Minimum Flow (mgd)	Peak Flow (mgd)	Total Daily Flow (mg)	Total Rain (in)	Peak Hourly Rain (in)	Peak Interval Rain (in)
6/1/2018 (Fri)	0.006	0.353	0.102	0.00	0.00	0.00
6/2/2018 (Sat)	0.005	0.324	0.108	0.00	0.00	0.00
6/3/2018 (Sun)	0.004	0.361	0.104	0.00	0.00	0.00
6/4/2018 (Mon)	0.004	0.286	0.082	0.45	0.28	0.05
6/5/2018 (Tue)	0.006	0.300	0.092	0.14	0.12	0.02
6/6/2018 (Wed)	0.004	0.288	0.096	0.00	0.00	0.00
6/7/2018 (Thu)	0.005	0.337	0.098	0.00	0.00	0.00
6/8/2018 (Fri)	0.005	0.264	0.095	0.00	0.00	0.00
6/9/2018 (Sat)	0.004	0.333	0.103	0.00	0.00	0.00
6/10/2018 (Sun)	0.005	0.315	0.095	0.00	0.00	0.00
6/11/2018 (Mon)	0.005	0.303	0.094	0.00	0.00	0.00
6/12/2018 (Tue)	0.004	0.318	0.094	0.00	0.00	0.00
6/13/2018 (Wed)	0.006	0.339	0.088	0.01	0.01	0.01
6/14/2018 (Thu)	0.004	0.336	0.101	0.00	0.00	0.00
6/15/2018 (Fri)	0.005	0.277	0.090	0.01	0.01	0.01
6/16/2018 (Sat)	0.009	0.340	0.098	0.00	0.00	0.00
6/17/2018 (Sun)	0.005	0.343	0.094	0.00	0.00	0.00
6/18/2018 (Mon)	0.005	0.288	0.089	0.12	0.08	0.03
6/19/2018 (Tue)	0.006	0.251	0.093	0.02	0.01	0.01
6/20/2018 (Wed)	0.006	0.305	0.095	0.00	0.00	0.00
6/21/2018 (Thu)	0.010	0.212	0.020	0.00	0.00	0.00
6/22/2018 (Fri)				0.00	0.00	0.00
Total for period			1.930	0.75		
Min:			0.004			
Avg:			0.092			
Max:			0.361			

Summary Flow Report

Site:

10-1

9 Washington Avenue

Manhole 10-1



Natick, MA

22.75" Circular Line

Date	Minimum Flow (mgd)	Peak Flow (mgd)	Total Daily Flow (mg)	Total Rain (in)	Peak Hourly Rain (in)	Peak Interval Rain (in)
3/26/2018 (Mon)				0.01	0.01	0.01
3/27/2018 (Tue)	1.778	2.488	0.866	0.00	0.00	0.00
3/28/2018 (Wed)	1.415	2.586	2.020	0.01	0.01	0.01
3/29/2018 (Thu)	1.386	2.684	1.999	0.02	0.02	0.01
3/30/2018 (Fri)	1.438	2.549	2.031	0.07	0.05	0.02
3/31/2018 (Sat)	1.347	2.540	1.966	0.00	0.00	0.00
4/1/2018 (Sun)	1.268	2.696	1.905	0.00	0.00	0.00
4/2/2018 (Mon)	1.188	2.442	1.877	0.14	0.14	0.02
4/3/2018 (Tue)	1.157	2.511	1.830	0.47	0.14	0.02
4/4/2018 (Wed)	1.260	2.462	1.949	0.21	0.11	0.02
4/5/2018 (Thu)	1.288	2.365	1.899	0.00	0.00	0.00
4/6/2018 (Fri)	1.226	2.343	1.872	0.29	0.07	0.01
4/7/2018 (Sat)	1.212	2.672	1.906	0.03	0.02	0.01
4/8/2018 (Sun)	1.154	2.518	1.884	0.00	0.00	0.00
4/9/2018 (Mon)	1.143	2.319	1.772	0.00	0.00	0.00
4/10/2018 (Tue)	1.069	2.282	1.706	0.00	0.00	0.00
4/11/2018 (Wed)	1.028	2.197	1.687	0.00	0.00	0.00
4/12/2018 (Thu)	1.009	2.099	1.652	0.07	0.07	0.01
4/13/2018 (Fri)	1.008	2.133	1.612	0.00	0.00	0.00
4/14/2018 (Sat)	0.921	2.427	1.545	0.00	0.00	0.00
4/15/2018 (Sun)	0.915	2.119	1.505	0.13	0.05	0.01
4/16/2018 (Mon)	0.999	3.691	2.277	1.84	0.37	0.07
4/17/2018 (Tue)	2.279	3.329	2.750	0.00	0.00	0.00
4/18/2018 (Wed)	1.930	3.078	2.457	0.00	0.00	0.00
4/19/2018 (Thu)	1.779	2.833	2.282	0.22	0.07	0.01
4/20/2018 (Fri)	1.659	2.647	2.157	0.00	0.00	0.00
4/21/2018 (Sat)	1.545	2.760	2.054	0.00	0.00	0.00
4/22/2018 (Sun)	1.415	2.520	2.002	0.00	0.00	0.00
4/23/2018 (Mon)	1.294	2.483	1.893	0.00	0.00	0.00
4/24/2018 (Tue)	1.204	2.340	1.813	0.00	0.00	0.00
4/25/2018 (Wed)	1.164	2.685	1.961	1.25	0.33	0.09
4/26/2018 (Thu)	1.674	2.779	2.255	0.04	0.02	0.01
4/27/2018 (Fri)	1.639	2.708	2.196	0.34	0.19	0.03
4/28/2018 (Sat)	1.638	2.781	2.189	0.00	0.00	0.00
4/29/2018 (Sun)	1.554	2.708	2.111	0.10	0.04	0.03
4/30/2018 (Mon)	1.306	2.632	2.027	0.12	0.04	0.02
Total for period			67.907	5.36		

Min: 0.915
 Avg: 1.940
 Max: 3.691

Summary Flow Report

Site:

10-1

9 Washington Avenue

Natick, MA



22.75" Circular Line

Date	Minimum Flow (mgd)	Peak Flow (mgd)	Total Daily Flow (mg)	Total Rain (in)	Peak Hourly Rain (in)	Peak Interval Rain (in)
5/1/2018 (Tue)	1.369	2.543	1.949	0.00	0.00	0.00
5/2/2018 (Wed)	1.297	2.385	1.886	0.00	0.00	0.00
5/3/2018 (Thu)	1.225	2.343	1.815	0.01	0.01	0.01
5/4/2018 (Fri)	1.176	2.347	1.765	0.02	0.01	0.01
5/5/2018 (Sat)	1.097	2.275	1.687	0.00	0.00	0.00
5/6/2018 (Sun)	1.016	2.201	1.671	0.36	0.23	0.03
5/7/2018 (Mon)	1.063	2.185	1.644	0.00	0.00	0.00
5/8/2018 (Tue)	0.986	2.160	1.626	0.00	0.00	0.00
5/9/2018 (Wed)	0.910	2.267	1.595	0.00	0.00	0.00
5/10/2018 (Thu)	0.847	2.203	1.564	0.00	0.00	0.00
5/11/2018 (Fri)	0.780	2.135	1.498	0.00	0.00	0.00
5/12/2018 (Sat)	0.730	2.129	1.454	0.22	0.07	0.01
5/13/2018 (Sun)	0.732	2.225	1.474	0.00	0.00	0.00
5/14/2018 (Mon)	0.712	2.052	1.473	0.00	0.00	0.00
5/15/2018 (Tue)	0.816	2.219	1.489	0.83	0.60	0.29
5/16/2018 (Wed)	0.854	2.112	1.519	0.01	0.01	0.01
5/17/2018 (Thu)	0.855	2.006	1.507	0.00	0.00	0.00
5/18/2018 (Fri)	0.810	1.983	1.452	0.00	0.00	0.00
5/19/2018 (Sat)	0.858	1.981	1.432	0.19	0.04	0.01
5/20/2018 (Sun)	0.835	2.056	1.470	0.05	0.03	0.01
5/21/2018 (Mon)	0.759	1.892	1.413	0.00	0.00	0.00
5/22/2018 (Tue)	0.683	1.932	1.339	0.03	0.01	0.01
5/23/2018 (Wed)	0.718	1.911	1.384	0.10	0.10	0.02
5/24/2018 (Thu)	0.634	1.870	1.367	0.00	0.00	0.00
5/25/2018 (Fri)	0.687	1.858	1.335	0.00	0.00	0.00
5/26/2018 (Sat)	0.682	1.758	1.234	0.00	0.00	0.00
5/27/2018 (Sun)	0.621	1.693	1.170	0.08	0.03	0.01
5/28/2018 (Mon)	0.598	1.838	1.257	0.01	0.01	0.01
5/29/2018 (Tue)	0.619	1.926	1.318	0.00	0.00	0.00
5/30/2018 (Wed)	0.591	1.790	1.283	0.00	0.00	0.00
5/31/2018 (Thu)	0.617	1.754	1.251	0.00	0.00	0.00
Total for period			46.319	1.91		
					Min: 0.591	
					Avg: 1.494	
					Max: 2.543	

Summary Flow Report

Site:

10-1

9 Washington Avenue

Natick, MA



22.75" Circular Line

Date	Minimum Flow (mgd)	Peak Flow (mgd)	Total Daily Flow (mg)	Total Rain (in)	Peak Hourly Rain (in)	Peak Interval Rain (in)
6/1/2018 (Fri)	0.576	1.778	1.242	0.00	0.00	0.00
6/2/2018 (Sat)	0.568	2.007	1.202	0.00	0.00	0.00
6/3/2018 (Sun)	0.549	1.847	1.222	0.00	0.00	0.00
6/4/2018 (Mon)	0.549	1.791	1.259	0.45	0.28	0.05
6/5/2018 (Tue)	0.582	1.830	1.255	0.14	0.12	0.02
6/6/2018 (Wed)	0.593	1.815	1.248	0.00	0.00	0.00
6/7/2018 (Thu)	0.533	1.860	1.245	0.00	0.00	0.00
6/8/2018 (Fri)	0.543	1.772	1.213	0.00	0.00	0.00
6/9/2018 (Sat)	0.419	1.812	1.140	0.00	0.00	0.00
6/10/2018 (Sun)	0.473	1.875	1.165	0.00	0.00	0.00
6/11/2018 (Mon)	0.471	1.687	1.162	0.00	0.00	0.00
6/12/2018 (Tue)	0.460	1.781	1.157	0.00	0.00	0.00
6/13/2018 (Wed)	0.455	1.809	1.129	0.01	0.01	0.01
6/14/2018 (Thu)	0.438	1.764	1.126	0.00	0.00	0.00
6/15/2018 (Fri)	0.454	1.650	1.115	0.01	0.01	0.01
6/16/2018 (Sat)	0.398	1.710	1.061	0.00	0.00	0.00
6/17/2018 (Sun)	0.420	1.832	1.083	0.00	0.00	0.00
6/18/2018 (Mon)	0.419	1.772	1.131	0.12	0.08	0.03
6/19/2018 (Tue)	0.378	1.720	1.097	0.02	0.01	0.01
6/20/2018 (Wed)	0.386	1.618	1.094	0.00	0.00	0.00
6/21/2018 (Thu)	0.449	1.637	0.332	0.00	0.00	0.00
6/22/2018 (Fri)				0.00	0.00	0.00
Total for period			23.677	0.75		
					Min: 0.378	
					Avg: 1.127	
					Max: 2.007	

Summary Flow Report

Site:

18-1

7 Elm Street

Manhole 18-1



Natick, MA

17.5" Circular Line

Date	Minimum Flow (mgd)	Peak Flow (mgd)	Total Daily Flow (mg)	Total Rain (in)	Peak Hourly Rain (in)	Peak Interval Rain (in)
3/26/2018 (Mon)				0.01	0.01	0.01
3/27/2018 (Tue)				0.00	0.00	0.00
3/28/2018 (Wed)	0.674	1.117	0.637	0.01	0.01	0.01
3/29/2018 (Thu)	0.621	1.253	0.881	0.02	0.02	0.01
3/30/2018 (Fri)	0.637	1.111	0.890	0.07	0.05	0.02
3/31/2018 (Sat)	0.598	1.286	0.874	0.00	0.00	0.00
4/1/2018 (Sun)	0.598	1.238	0.884	0.00	0.00	0.00
4/2/2018 (Mon)	0.584	1.141	0.818	0.14	0.14	0.02
4/3/2018 (Tue)	0.547	1.139	0.810	0.47	0.14	0.02
4/4/2018 (Wed)	0.606	1.160	0.889	0.21	0.11	0.02
4/5/2018 (Thu)	0.601	1.180	0.861	0.00	0.00	0.00
4/6/2018 (Fri)	0.574	1.176	0.841	0.29	0.07	0.01
4/7/2018 (Sat)	0.597	1.163	0.863	0.03	0.02	0.01
4/8/2018 (Sun)	0.551	1.119	0.854	0.00	0.00	0.00
4/9/2018 (Mon)	0.523	1.143	0.795	0.00	0.00	0.00
4/10/2018 (Tue)	0.497	1.103	0.775	0.00	0.00	0.00
4/11/2018 (Wed)	0.512	1.060	0.758	0.00	0.00	0.00
4/12/2018 (Thu)	0.507	1.087	0.760	0.07	0.07	0.01
4/13/2018 (Fri)	0.502	1.031	0.722	0.00	0.00	0.00
4/14/2018 (Sat)	0.466	1.160	0.710	0.00	0.00	0.00
4/15/2018 (Sun)	0.453	1.035	0.694	0.13	0.05	0.01
4/16/2018 (Mon)	0.475	1.807	1.067	1.84	0.37	0.07
4/17/2018 (Tue)	1.076	1.653	1.391	0.00	0.00	0.00
4/18/2018 (Wed)	0.958	1.449	1.198	0.00	0.00	0.00
4/19/2018 (Thu)	0.874	1.386	1.133	0.22	0.07	0.01
4/20/2018 (Fri)	0.805	1.335	1.040	0.00	0.00	0.00
4/21/2018 (Sat)	0.755	1.269	0.987	0.00	0.00	0.00
4/22/2018 (Sun)	0.682	1.228	0.953	0.00	0.00	0.00
4/23/2018 (Mon)	0.639	1.222	0.918	0.00	0.00	0.00
4/24/2018 (Tue)	0.661	1.159	0.888	0.00	0.00	0.00
4/25/2018 (Wed)	0.602	1.446	0.930	1.25	0.33	0.09
4/26/2018 (Thu)	0.870	1.456	1.133	0.04	0.02	0.01
4/27/2018 (Fri)	0.818	1.351	1.088	0.34	0.19	0.03
4/28/2018 (Sat)	0.843	1.369	1.111	0.00	0.00	0.00
4/29/2018 (Sun)	0.791	1.311	1.077	0.10	0.04	0.03
4/30/2018 (Mon)	0.783	1.307	1.010	0.12	0.04	0.02
Total for period			31.243	5.36		

Min: 0.453
 Avg: 0.919
 Max: 1.807

Summary Flow Report

Site:

18-1

7 Elm Street

Natick, MA



17.5" Circular Line

Date	Minimum Flow (mgd)	Peak Flow (mgd)	Total Daily Flow (mg)	Total Rain (in)	Peak Hourly Rain (in)	Peak Interval Rain (in)
5/1/2018 (Tue)	0.710	1.286	0.972	0.00	0.00	0.00
5/2/2018 (Wed)	0.664	1.304	0.932	0.00	0.00	0.00
5/3/2018 (Thu)	0.621	1.269	0.885	0.01	0.01	0.01
5/4/2018 (Fri)	0.568	1.185	0.822	0.02	0.01	0.01
5/5/2018 (Sat)	0.527	1.031	0.786	0.00	0.00	0.00
5/6/2018 (Sun)	0.518	1.035	0.799	0.36	0.23	0.03
5/7/2018 (Mon)	0.518	1.103	0.771	0.00	0.00	0.00
5/8/2018 (Tue)	0.498	1.111	0.741	0.00	0.00	0.00
5/9/2018 (Wed)	0.455	0.955	0.688	0.00	0.00	0.00
5/10/2018 (Thu)	0.437	0.964	0.652	0.00	0.00	0.00
5/11/2018 (Fri)	0.408	0.934	0.623	0.00	0.00	0.00
5/12/2018 (Sat)	0.383	0.942	0.630	0.22	0.07	0.01
5/13/2018 (Sun)	0.363	0.915	0.616	0.00	0.00	0.00
5/14/2018 (Mon)	0.364	0.896	0.601	0.00	0.00	0.00
5/15/2018 (Tue)	0.366	1.091	0.640	0.83	0.60	0.29
5/16/2018 (Wed)	0.418	0.913	0.647	0.01	0.01	0.01
5/17/2018 (Thu)	0.382	0.890	0.646	0.00	0.00	0.00
5/18/2018 (Fri)	0.387	0.942	0.593	0.00	0.00	0.00
5/19/2018 (Sat)	0.352	0.853	0.596	0.19	0.04	0.01
5/20/2018 (Sun)	0.392	0.906	0.629	0.05	0.03	0.01
5/21/2018 (Mon)	0.342	0.861	0.580	0.00	0.00	0.00
5/22/2018 (Tue)	0.352	0.863	0.594	0.03	0.01	0.01
5/23/2018 (Wed)	0.367	0.950	0.605	0.10	0.10	0.02
5/24/2018 (Thu)	0.356	0.937	0.594	0.00	0.00	0.00
5/25/2018 (Fri)	0.344	0.866	0.577	0.00	0.00	0.00
5/26/2018 (Sat)	0.341	0.775	0.556	0.00	0.00	0.00
5/27/2018 (Sun)	0.324	0.772	0.533	0.08	0.03	0.01
5/28/2018 (Mon)	0.288	0.848	0.567	0.01	0.01	0.01
5/29/2018 (Tue)	0.308	0.821	0.545	0.00	0.00	0.00
5/30/2018 (Wed)	0.281	0.809	0.513	0.00	0.00	0.00
5/31/2018 (Thu)	0.271	1.022	0.514	0.00	0.00	0.00
Total for period			20.448	1.91		
					Min: 0.271	
					Avg: 0.660	
					Max: 1.304	

Summary Flow Report

Site:

18-1

7 Elm Street

Natick, MA




17.5" Circular Line

Date	Minimum Flow (mgd)	Peak Flow (mgd)	Total Daily Flow (mg)	Total Rain (in)	Peak Hourly Rain (in)	Peak Interval Rain (in)
6/1/2018 (Fri)	0.264	0.797	0.515	0.00	0.00	0.00
6/2/2018 (Sat)	0.283	0.880	0.524	0.00	0.00	0.00
6/3/2018 (Sun)	0.273	0.770	0.518	0.00	0.00	0.00
6/4/2018 (Mon)	0.261	0.747	0.509	0.45	0.28	0.05
6/5/2018 (Tue)	0.262	0.777	0.495	0.14	0.12	0.02
6/6/2018 (Wed)	0.251	0.764	0.455	0.00	0.00	0.00
6/7/2018 (Thu)	0.214	0.735	0.440	0.00	0.00	0.00
6/8/2018 (Fri)	0.207	0.737	0.442	0.00	0.00	0.00
6/9/2018 (Sat)	0.234	0.695	0.462	0.00	0.00	0.00
6/10/2018 (Sun)	0.226	0.708	0.464	0.00	0.00	0.00
6/11/2018 (Mon)	0.204	0.710	0.449	0.00	0.00	0.00
6/12/2018 (Tue)	0.206	0.713	0.442	0.00	0.00	0.00
6/13/2018 (Wed)	0.210	0.705	0.444	0.01	0.01	0.01
6/14/2018 (Thu)	0.216	0.710	0.439	0.00	0.00	0.00
6/15/2018 (Fri)	0.204	0.698	0.434	0.01	0.01	0.01
6/16/2018 (Sat)	0.202	0.713	0.433	0.00	0.00	0.00
6/17/2018 (Sun)	0.195	0.690	0.435	0.00	0.00	0.00
6/18/2018 (Mon)	0.209	0.706	0.442	0.12	0.08	0.03
6/19/2018 (Tue)	0.208	0.696	0.428	0.02	0.01	0.01
6/20/2018 (Wed)	0.201	0.704	0.413	0.00	0.00	0.00
6/21/2018 (Thu)	0.182	0.664	0.404	0.00	0.00	0.00
6/22/2018 (Fri)	0.178	0.621	0.143	0.00	0.00	0.00
Total for period			9.732	0.75		
					Min: 0.178	
					Avg: 0.442	
					Max: 0.880	

Table 4
Point Repairs and Replacement Scope of Work

Street	Upstream MH	Downstream MH	Upstream MH Depth	Downstream MH Depth	Section Length (FT)	Mainline Pipe Material	Pipe Diameter (IN)	Proposed Scope of Work:	Approximate Length of Repair (ft)	Location	Natick Record Drawing Reference	Point Repair Bid Item Number	Mainline CIPP	Service Lateral CIPP Liner	Chimney Service CIPP Liner	Point Repair - Remove and Replace (mainline and services)	Chimney Service Point Repair - Remove and Replace	Short Liner at Capped Connections to seal infiltration/eliminate capped connection	Sewer Replacement >10 LF	Comments
BODEN LN.	14-4	14-155	5'0"	12.3'	215.8	Vitrified Clay Pipe	8		4'	@196' (Service Lateral) (From MH 14-4)	S256	41	Y	Y		Y			Repair collapsed service at 196' (possibly dead); D = 7'	
E. Evergreen Rd	7-43	7-42	7.5'	5.2'	281	VCP	8		43'	@85'-128'	S220	42						Y		
HEMLOCK DR.	14-49	14-48	6.3'	5'	305.9	Vitrified Clay Pipe	8		4'	@69' (Service Lateral): (From MH 14-49)	S286	41				Y			Point repair at service @ 68'; D = 6'	
HEMLOCK DR.	14-48	14-47	5'	4.6'	297	Vitrified Clay Pipe	8		11'	@286': (From MH-14-48)	S286	42						Y	Replace 286'-297' (@ MH); D = 6'	
North Main St	9-17	9-12	9'	9'	288	Vitrified Clay Pipe	10		7',6',7',5'	143', 173', 257', 267' (from MH 9-17)	S34	41	Y	Y		4			4 service lateral point repairs; all D = 8'	
Porter Rd	12-121	12-120	6'	6.5'	179	VCP	8		9'	@109-118'	S273	41	Y	Y						
Porter Rd	12-124	12-117	7.5'	9'	109	VCP	8		36'	@69-105'	S272	42	Y	Y				Y		
RICHARD RD.	6-22	6-21	6.5'	6.7'	291.2	Vitrified Clay Pipe	8		13'	@89'-102'	S296	42	Y	Y				Y	Replace 89'-102'; D = 8'	
W. Central St.	17-17	17-16	8.3'	11.2'	420	CIPP	8		5'	@403' (from MH 17-17)	S8	43		Y		1			Chimney point repair at D = 10.3'	
W. Central St.	17-9	17-8	28.7'	27.8'	353	CIPP	30		10-13' vert. each	@10.3, @81', @249.3, @319' (From MH 17-9)	S5	48					4		Chimney point repairs at D = 22.4', 19.3', 23.1' and 22.1'	
W. Central St.	17-12	17-9	25.7'	28.7'	366	CIPP	30		13' vert.	@311.8' (From MH 17-12)	S6	50					1		Chimney point repair at D = 23'	
W. Central St.	17-8	17-7	27.8'	24.3'	335	CIPP	30		13' vert.	@143.6' (From MH 17-8)	S5	49					1		Chimney point repair at D = 20'	
Washington Ave	17-22	17-14	21.2'	21.7'	294	CIPP	26		7' vert.	@145.2' (From MH 17-22)	S50	51			Y		1		Chimney point repair at D = 16'	
Washington Ave	10-1	17-22	20'	21.2'	196	CIPP	26		4' vert. each	@66.7', @108.4' (From MH 10-1)	S50	43			Y		2		Two Chimney point repairs both at D = 12'	
Washington Ave	10-64	10-7	17.9'	17.9'	334	CIPP	24		12' vert.	@151.6 (From 10-64)	S51	47			Y		1	3		
YORKSHIRE DR.	6-129	6-127	5.2'	8.7'	195	Polyethylene	8		4'	@119'; Replace Pipe @174' (Broken): (From MH 6-127)	S236	41	Y	Y		Y			Point repair at 175'; D = 8'	
North Main St	9-17	9-12	8'6"	9'6"	288	VCP	10/8		NA	@67': (From MH 9-17)	S34	38	Y	Y					Install MH At Intersection of Mechanic St and N. Main St	
Westview Ave.	11-322	New	±4'	±6'		AC	6"		470'		S34	38 and 42						Y	Install ±470 lf of 8-inch PVC sewer from MH 11-322 to new MH in Union St. ±167' downstream of MH 11-14, including 1 intermediate MH, and reconnection of all existing services	
NOTE: All point repairs and sewer replacement/installation work shall be completed prior to any CIPP lining work planned in the same sewer segment.																				

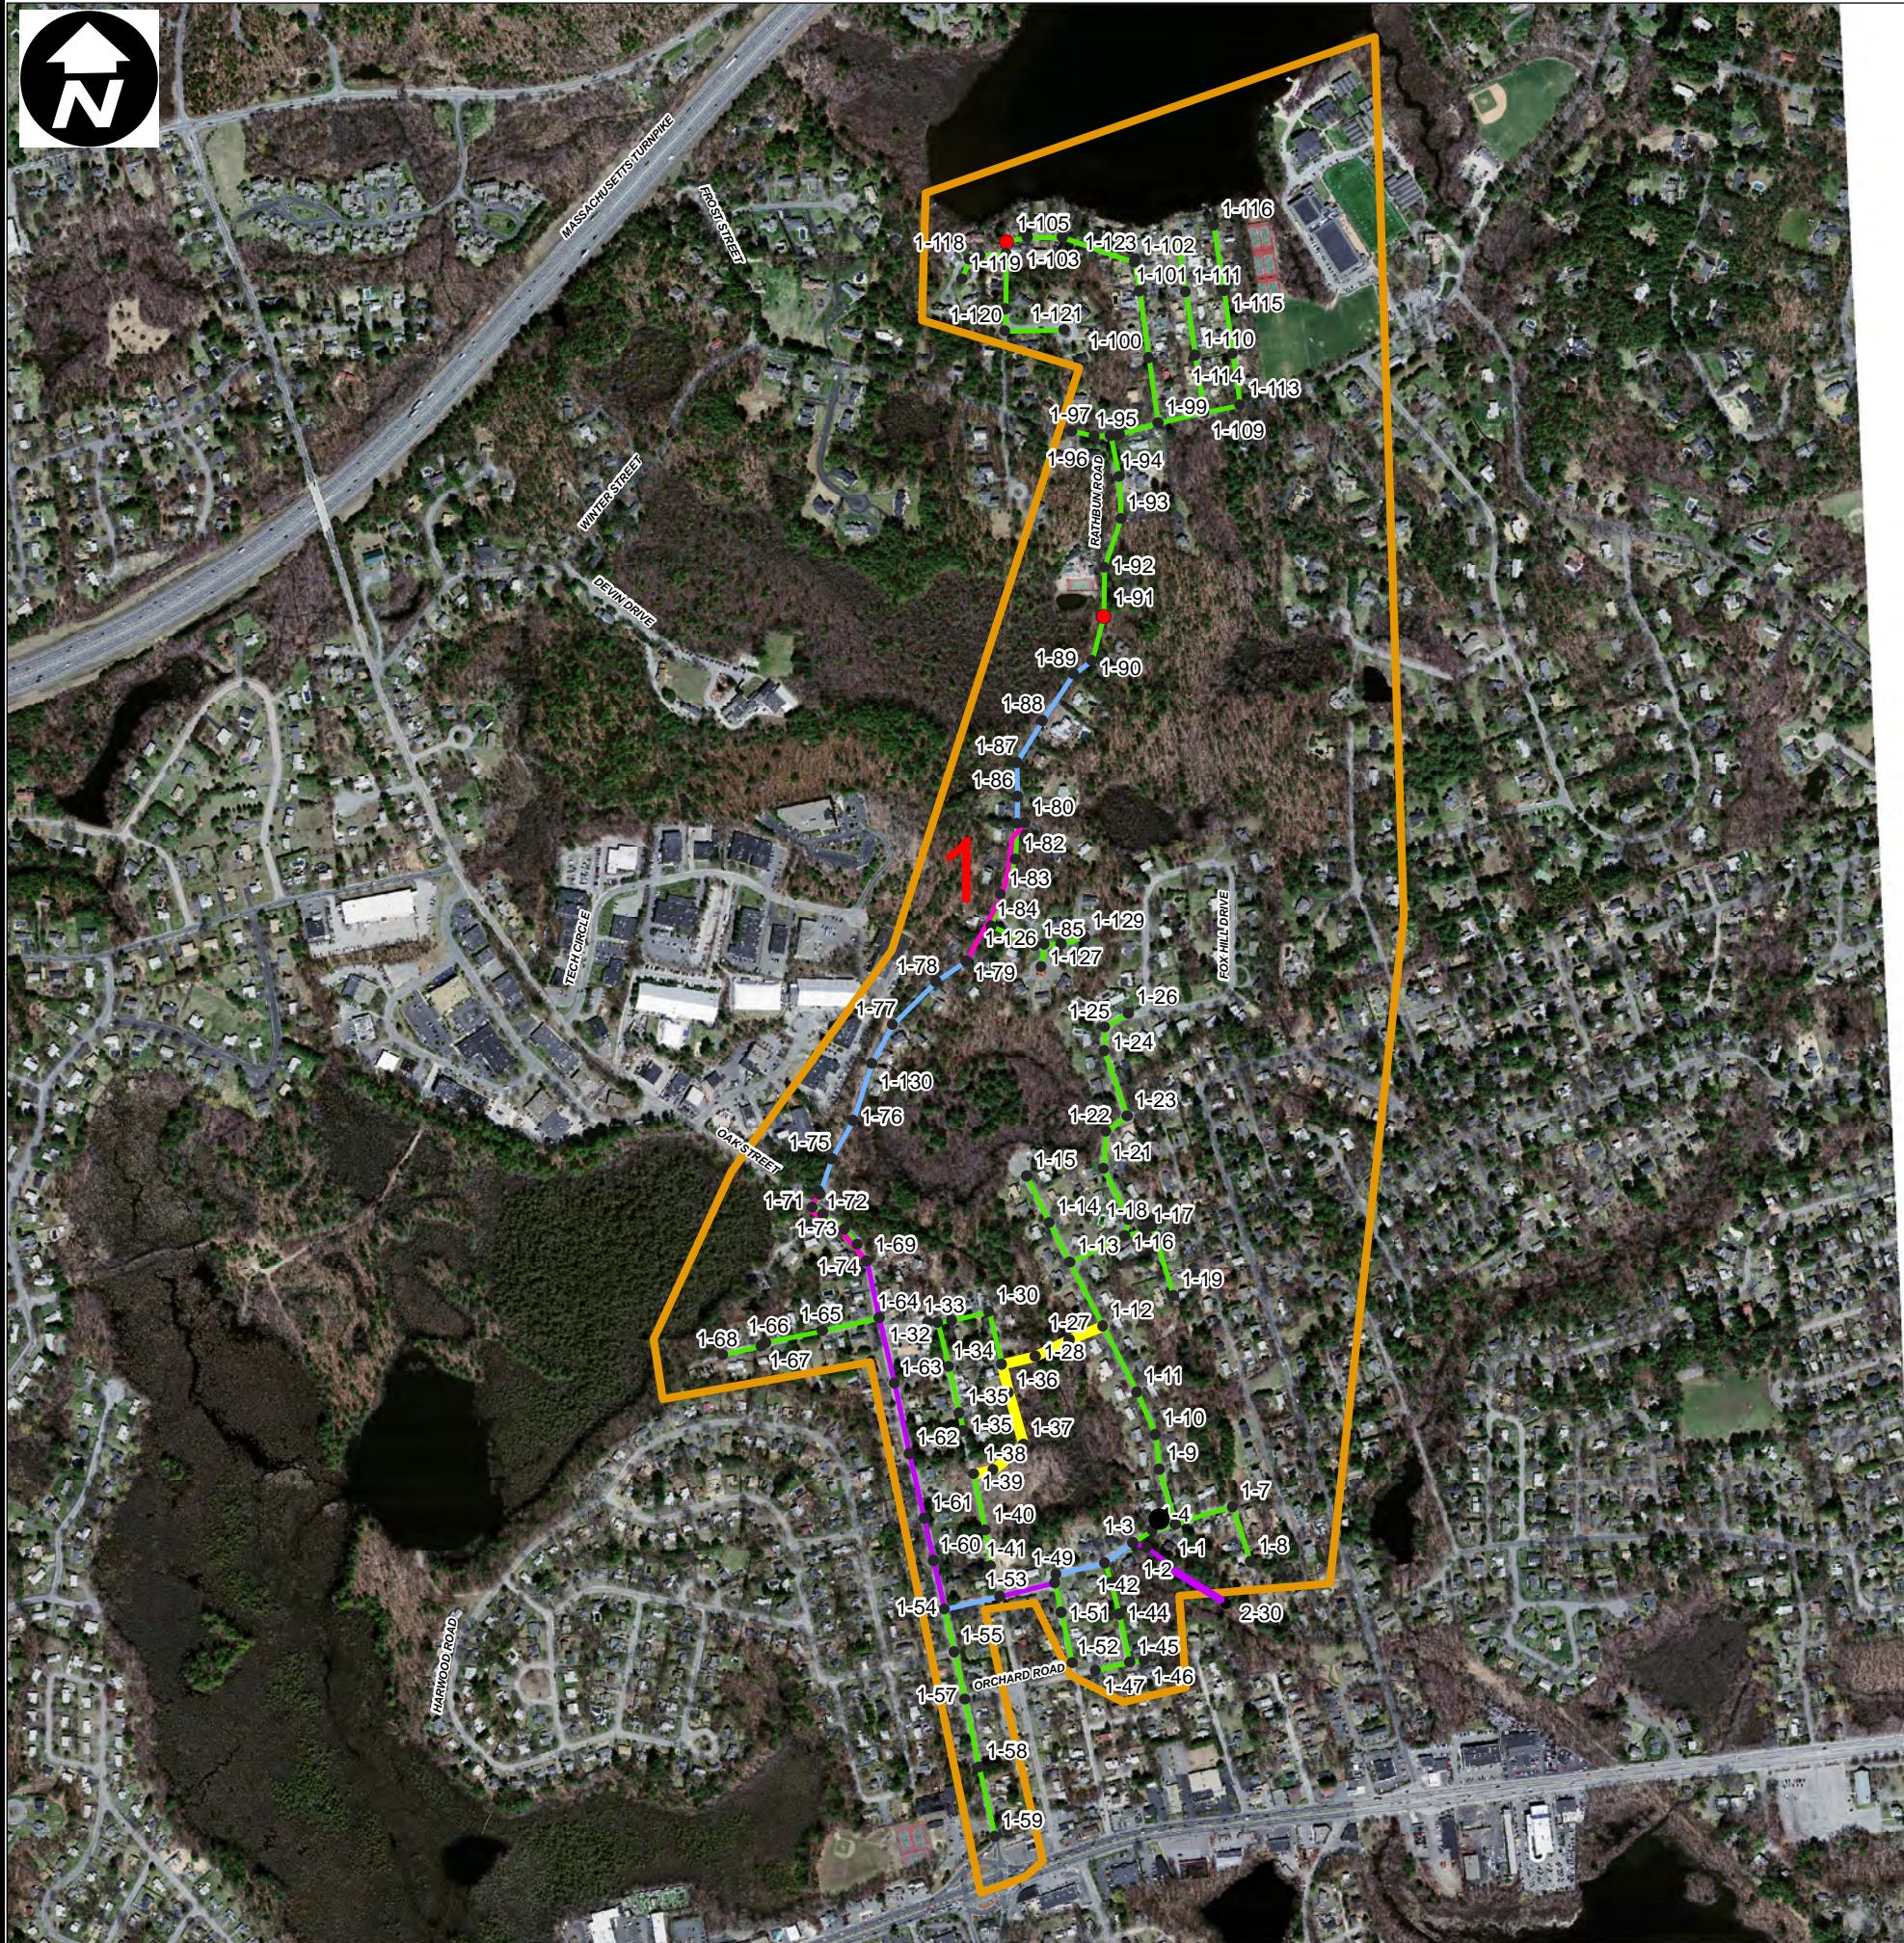

Legend

Sewer Pipes Contract Work

- OTHER
 - MANHOLES
 - Pipe Size**
 - WORK REQUIRED
 - 8"
 - 10"
 - 12"
 - Force Main
 - PIPES REQUIRING REPAIR

Notes

Parcel Source: Office of Geographic Information (MassGIS),
Commonwealth of Massachusetts,
Information Technology Division

Sewer Manhole Source: Town of Natick GIS Department.
Some sewer manholes locations are approximate.

Sewer Lines Source: Town of Natick GIS Department.

**DEPARTMENT OF PUBLIC WORKS
NATICK, MASSACHUSETTS**


**3 YEAR SEWER
REHABILITATION**

**DDENDUM
NO. 1**

Haley and Ward, Inc.
A division of CES Inc.
63 GREAT ROAD, SUITE 200,
MASSACHUSETTS 01754-2097
PHONE: (978) 648-6025
FAX: (978) 648-6088

SHEET NO.:	1 of 20	CHECKED	DATE	BY
CONTRACT NO.:	S-162			
SCALE:	1:9600	REVISED	DATE	BY
DATE DRAWN:	JUNE, 2020			
DRAWN BY:	LIC			
FILE NO.: NAT427-BSN-1-MXD				

BASIN 1

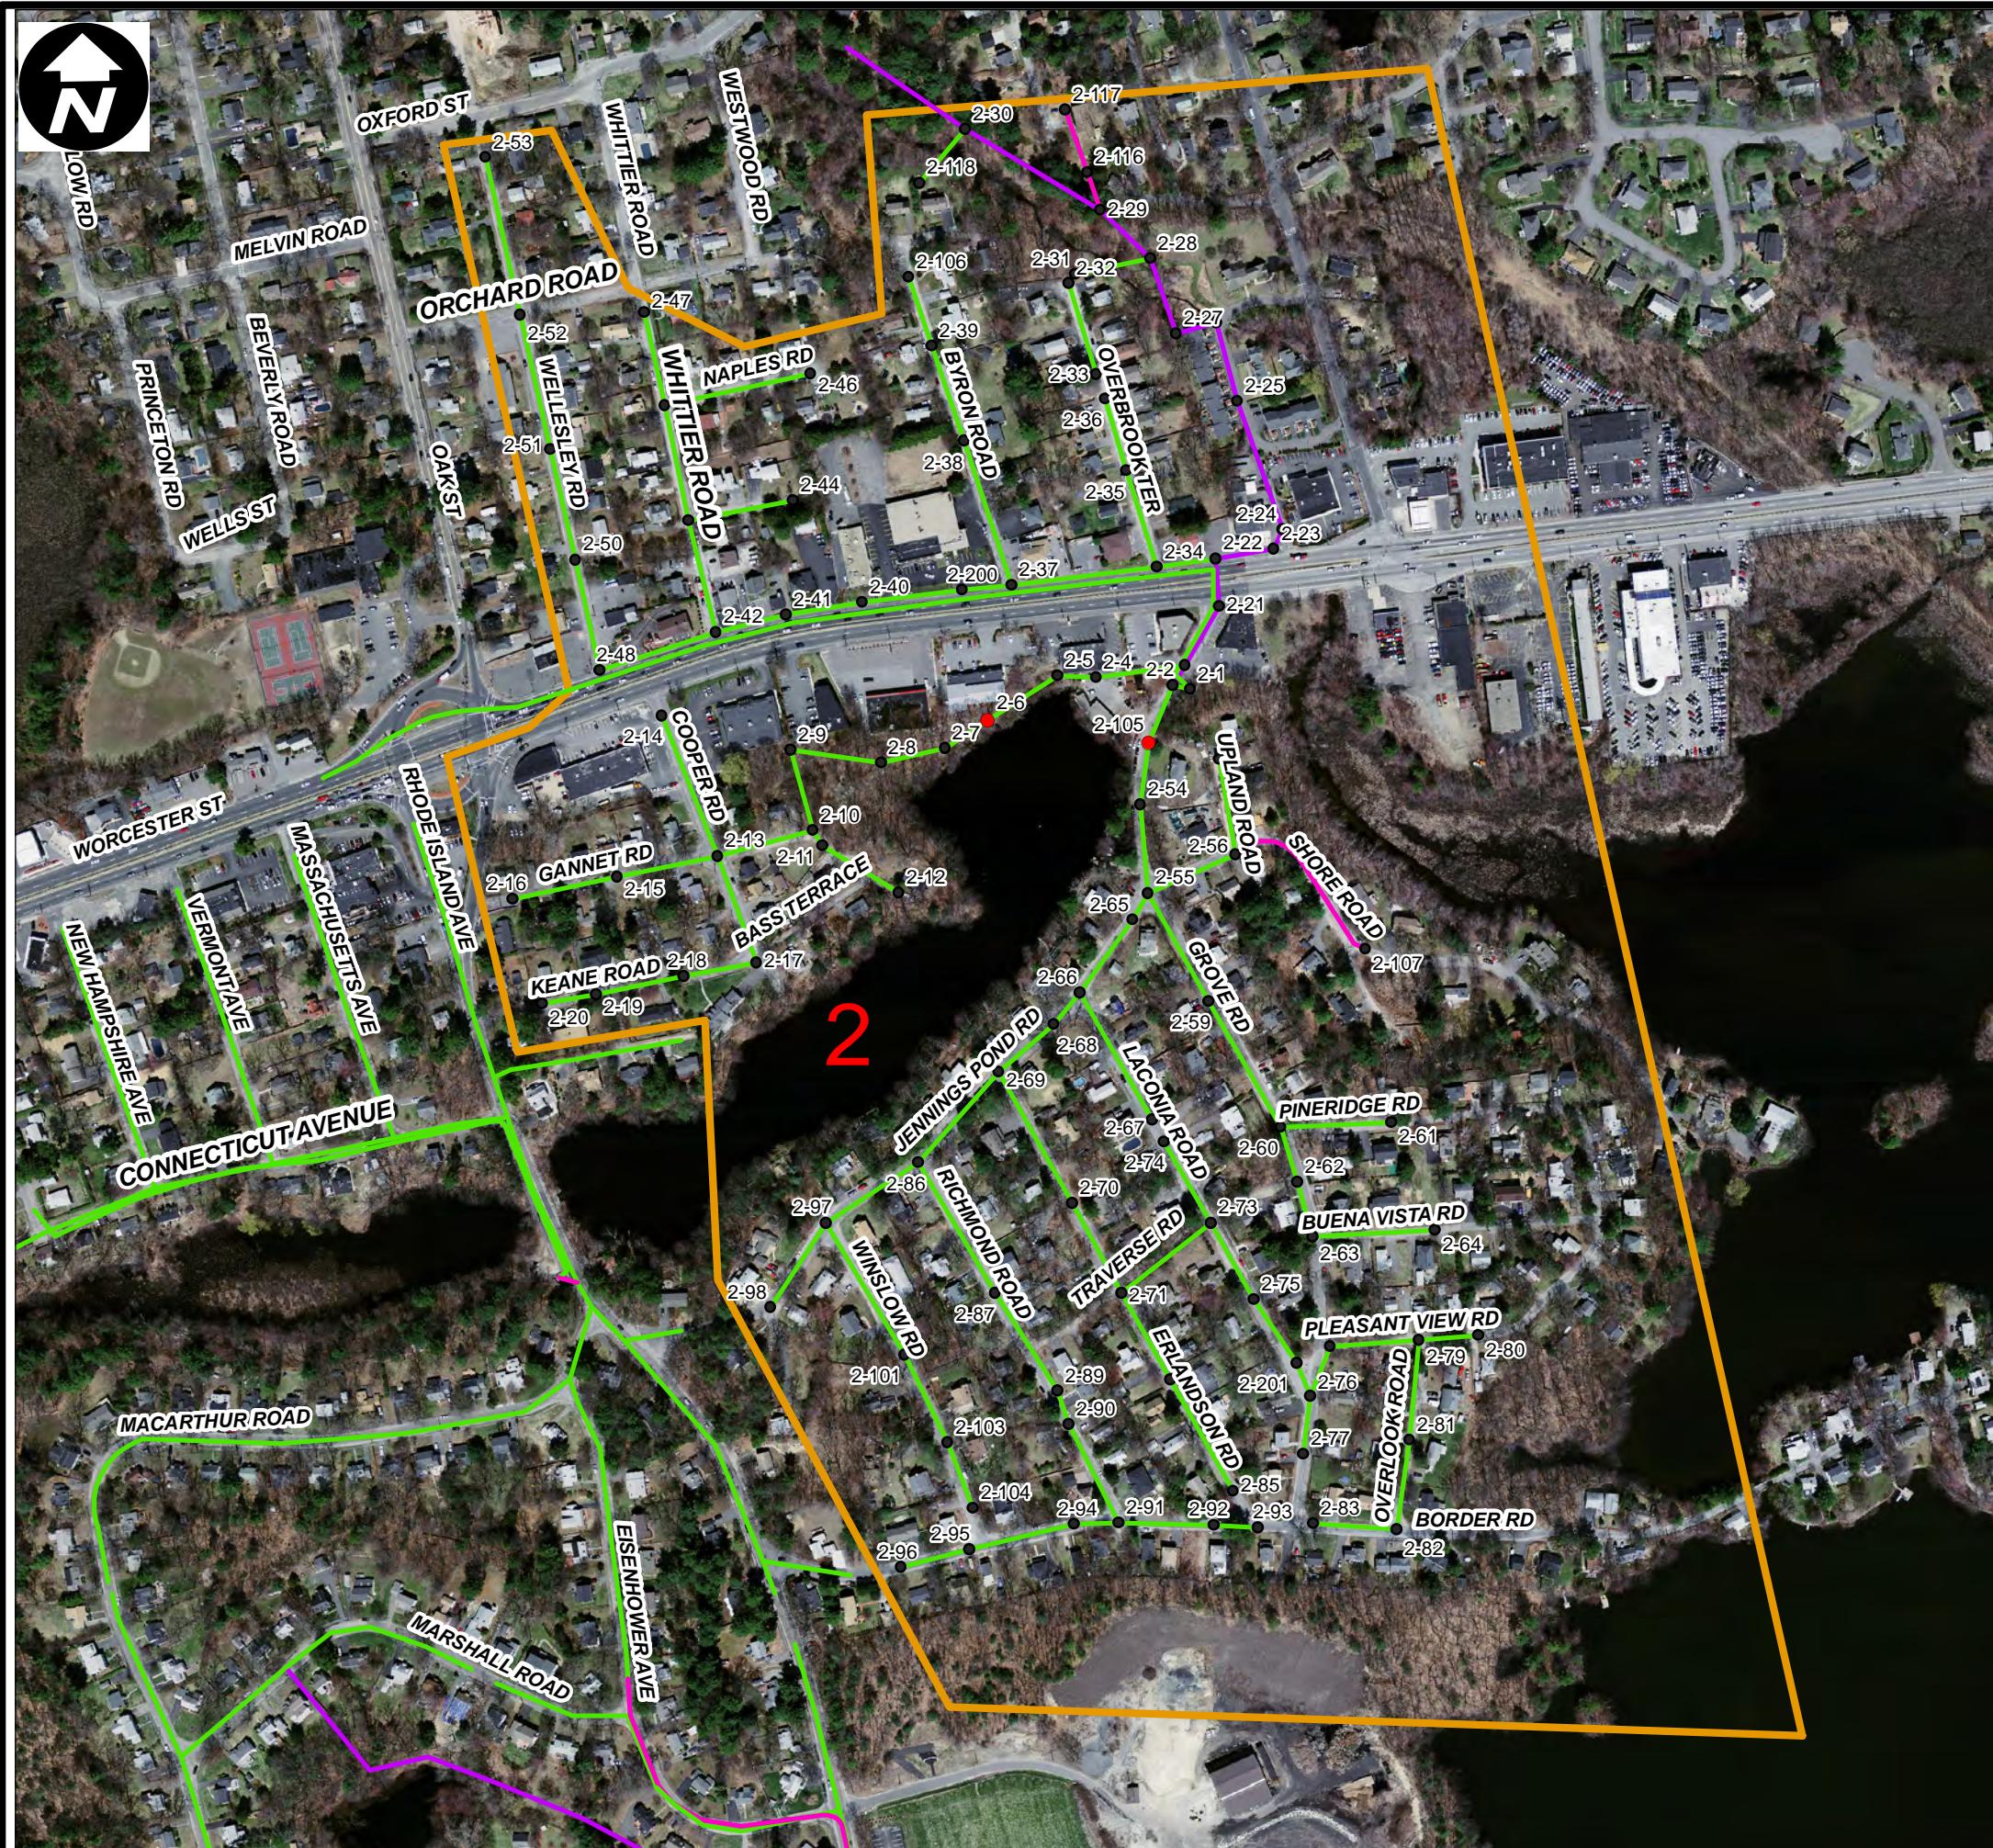

Legend

Sewer Line

— OTHER

PIPE SIZE

— 8"

— 10"

— 12"

— Force Main

Contract Work

- MANHOLES

- WORK REQUIRED

Notes:

Parcel Source: Office of Geographic Information (MassGIS), Commonwealth of Massachusetts, Information Technology Division

Sewer Manhole Source: Town of Natick GIS Department. Some sewer manholes locations are approximate.

Sewer Lines Source: Town of Natick GIS Department.

DEPARTMENT OF PUBLIC WORKS
NATICK, MASSACHUSETTS
3 YEAR SEWER REHABILITATION

**ADDENDUM
NO. 1**

**Haley and Ward, Inc.
A division of CES Inc.**
68 GREAT ROAD, SUITE 200,
MAYNARD, MASSACHUSETTS 01754-2097
PHONE: (978) 648-8025
FAX: (978) 648-8068
www.haleyward.com

SHEET NO.:	2 of 20	CHECKED	DATE	BY
CONTRACT NO.:	S-162	REvised	DATE	BY
SCALE:	1:4,200			
DATE DRAWN:	JUNE, 2020			
DRAWN BY:	LJC			
FILE NO.:	NATK27_BSN_2.MXD			

**BASIN
2**

420 210 0 420
Feet



Legend

Sewer Line

SIZE_

8"

10"

12"

Force Main

Contract Work

● MANHOLES

● WORK REQUIRED

Notes:

Parcel Source: Office of Geographic Information (MassGIS), Commonwealth of Massachusetts, Information Technology Division

Sewer Manhole Source: Town of Natick GIS Department. Some sewer manholes locations are approximate.

Sewer Lines Source: Town of Natick GIS Department.

DEPARTMENT OF PUBLIC WORKS
NATICK, MASSACHUSETTS
3 YEAR SEWER REHABILITATION

ADDENDUM
NO. 1

Haley and Ward, Inc.
A division of CES Inc.
68 GREAT ROAD, SUITE 200,
MAYNARD, MASSACHUSETTS 01754-2097
PHONE: (978) 648-8025
FAX: (978) 648-8068
www.haleyward.com

BASIN
3

550 275 0 550
Feet

SHEET NO.: 3 of 20


CONTRACT NO.: S-162

SCALE: 1:5,600

DATE DRAWN: JUNE, 2020

DRAWN BY: LJC

FILE NO.: NAT227_BSN_3.MXD

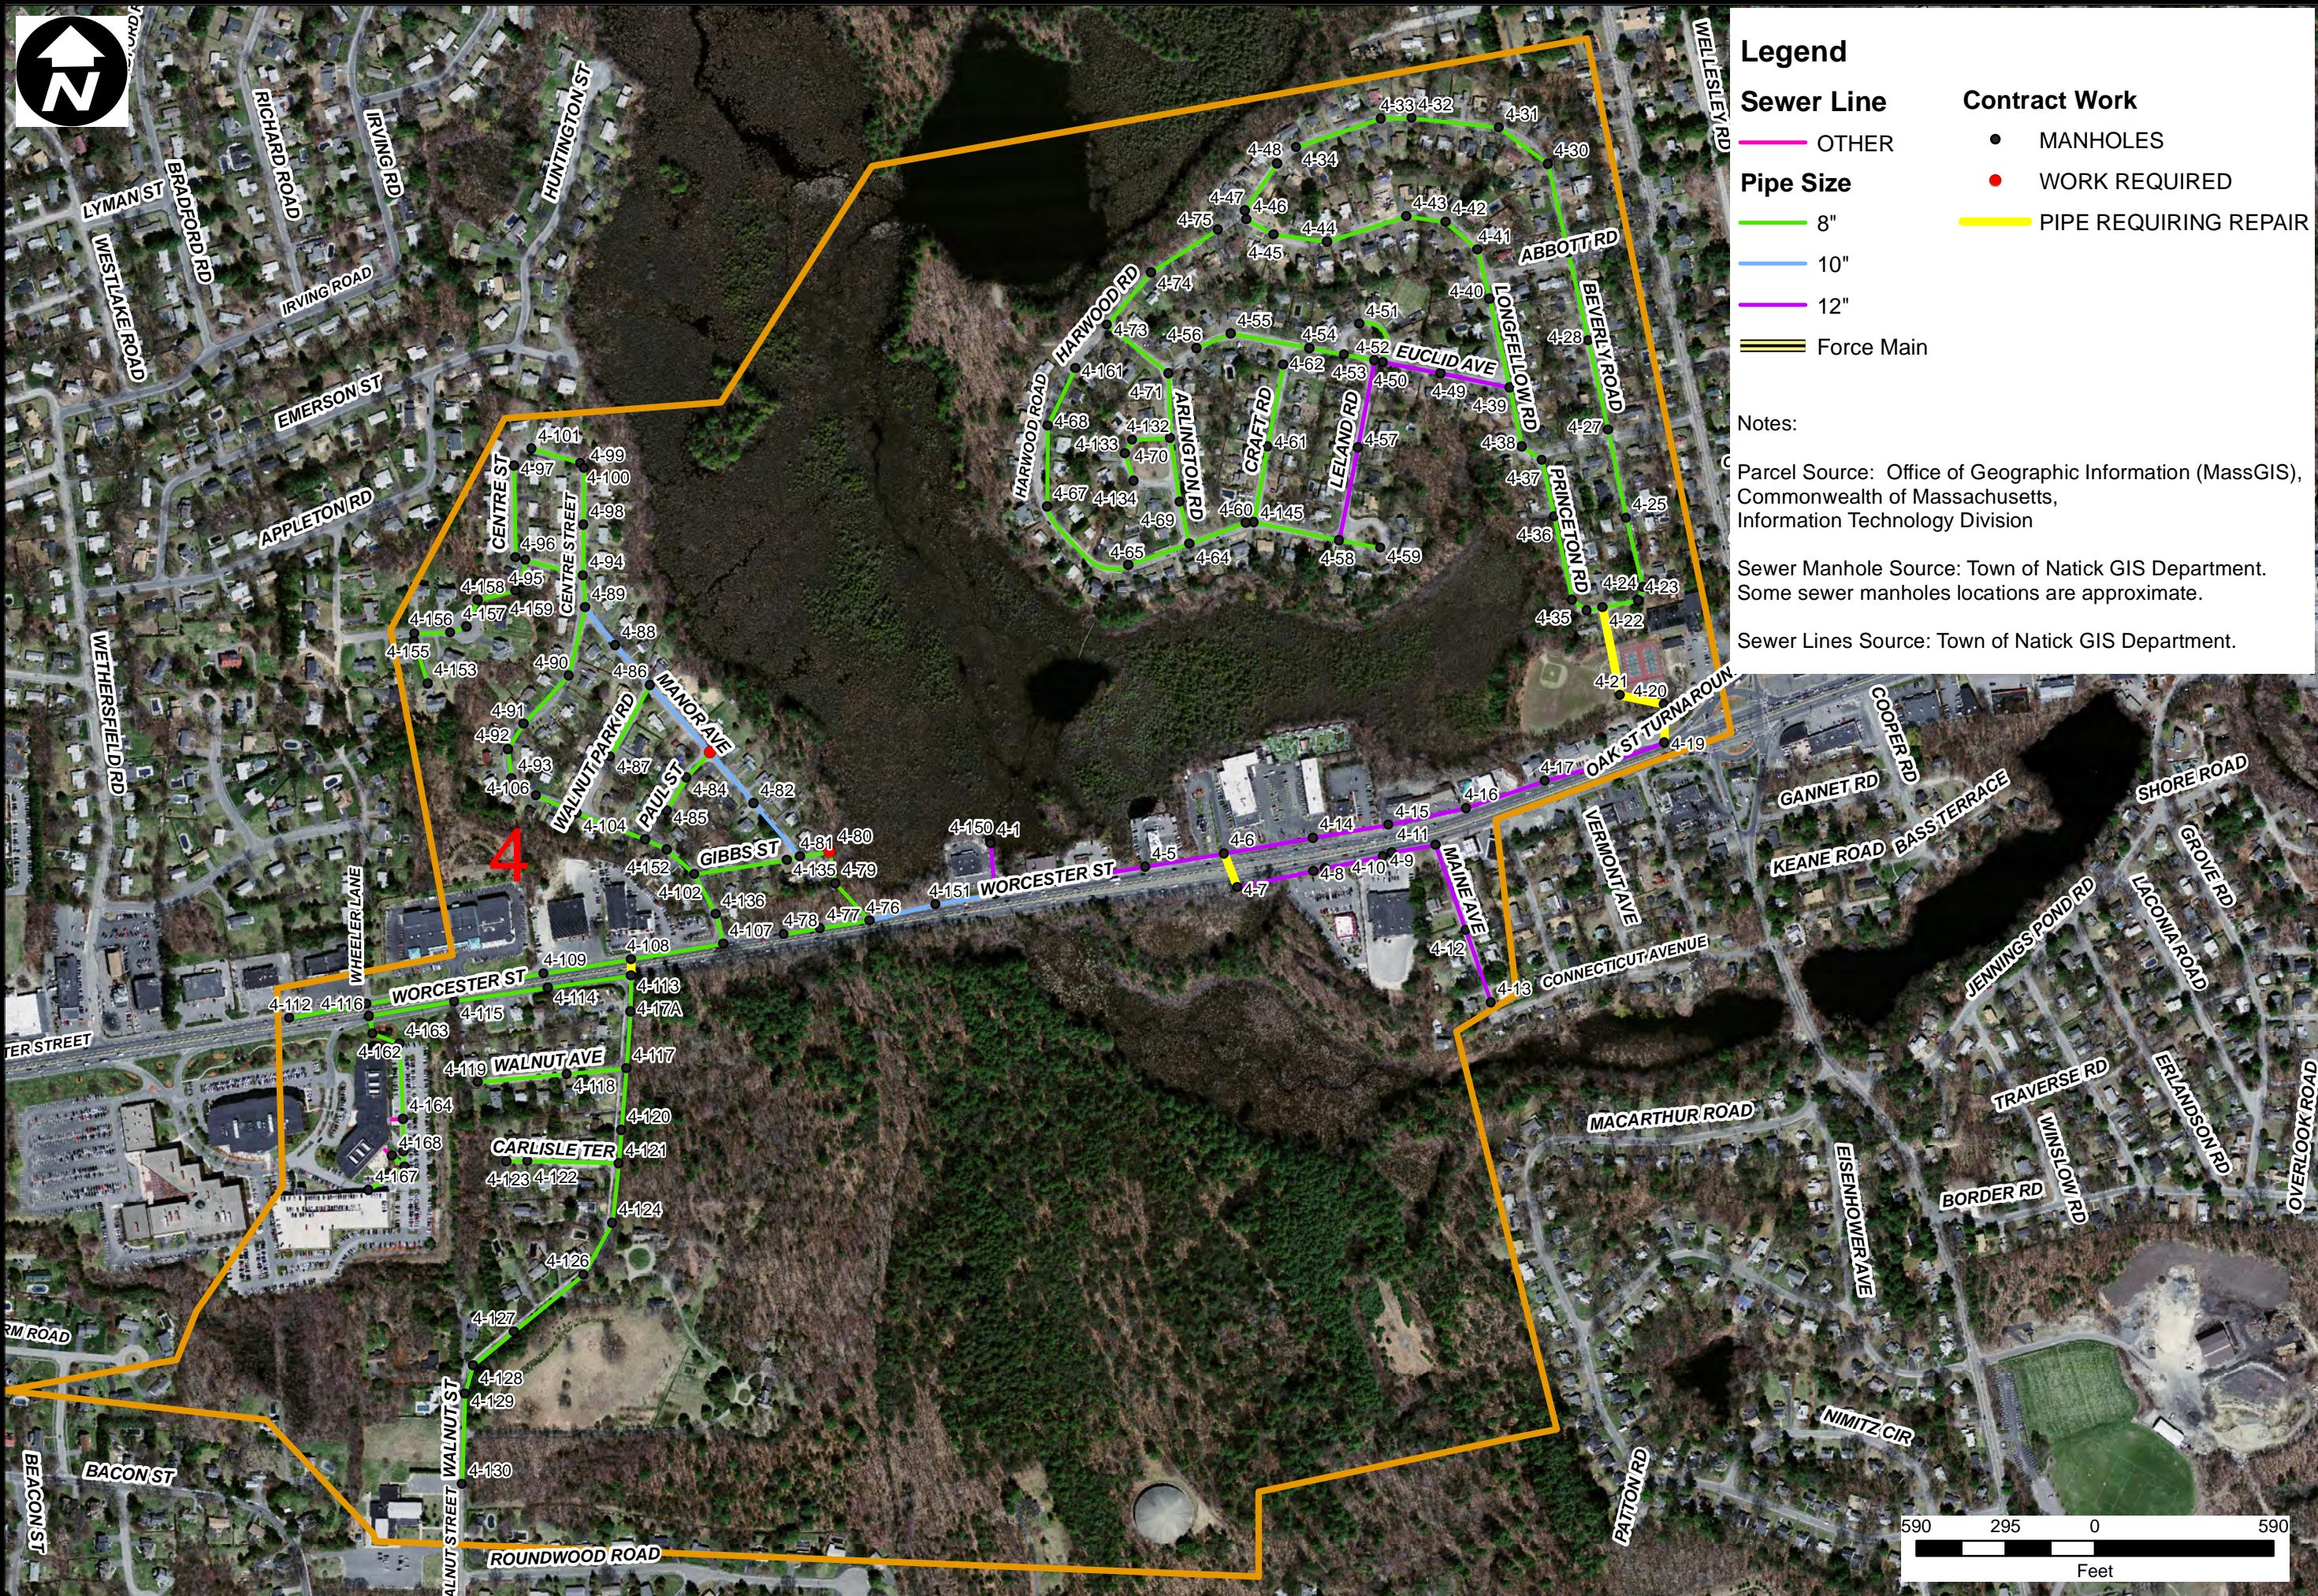

**DEPARTMENT OF PUBLIC WORKS
NATICK, MASSACHUSETTS**

**3 YEAR SEWER
REHABILITATION**

**ADDENDUM
NO. 1**

Haley and Ward, Inc.
A division of CES Inc.
#3 GREAT ROAD, SUITE 200,
MAYNARD, MASSACHUSETTS 01754-2007
PHONE: (978) 648-6025
FAX: (978) 648-6068

SHEET NO.: 4 of 20
CONTRACT NO.: S-162
SCALE: 1:6,000
DATE DRAWN: JUNE, 2020
DRAWN BY: LJC

BASIN 4

Legend

Sewer Line

Other

Pipe Size

8"

10"

12"

SMH_Join

Contract Work

- MANHOLES

- WORK REQUIRED

PIPES REQUIRING REPAIR

Force Main


Notes:

Parcel Source: Office of Geographic Information (MassGIS), Commonwealth of Massachusetts, Information Technology Division

Sewer Manhole Source: Town of Natick GIS Department. Some sewer manholes locations are approximate.

Sewer Lines Source: Town of Natick GIS Department.

900 450 0 900
Feet

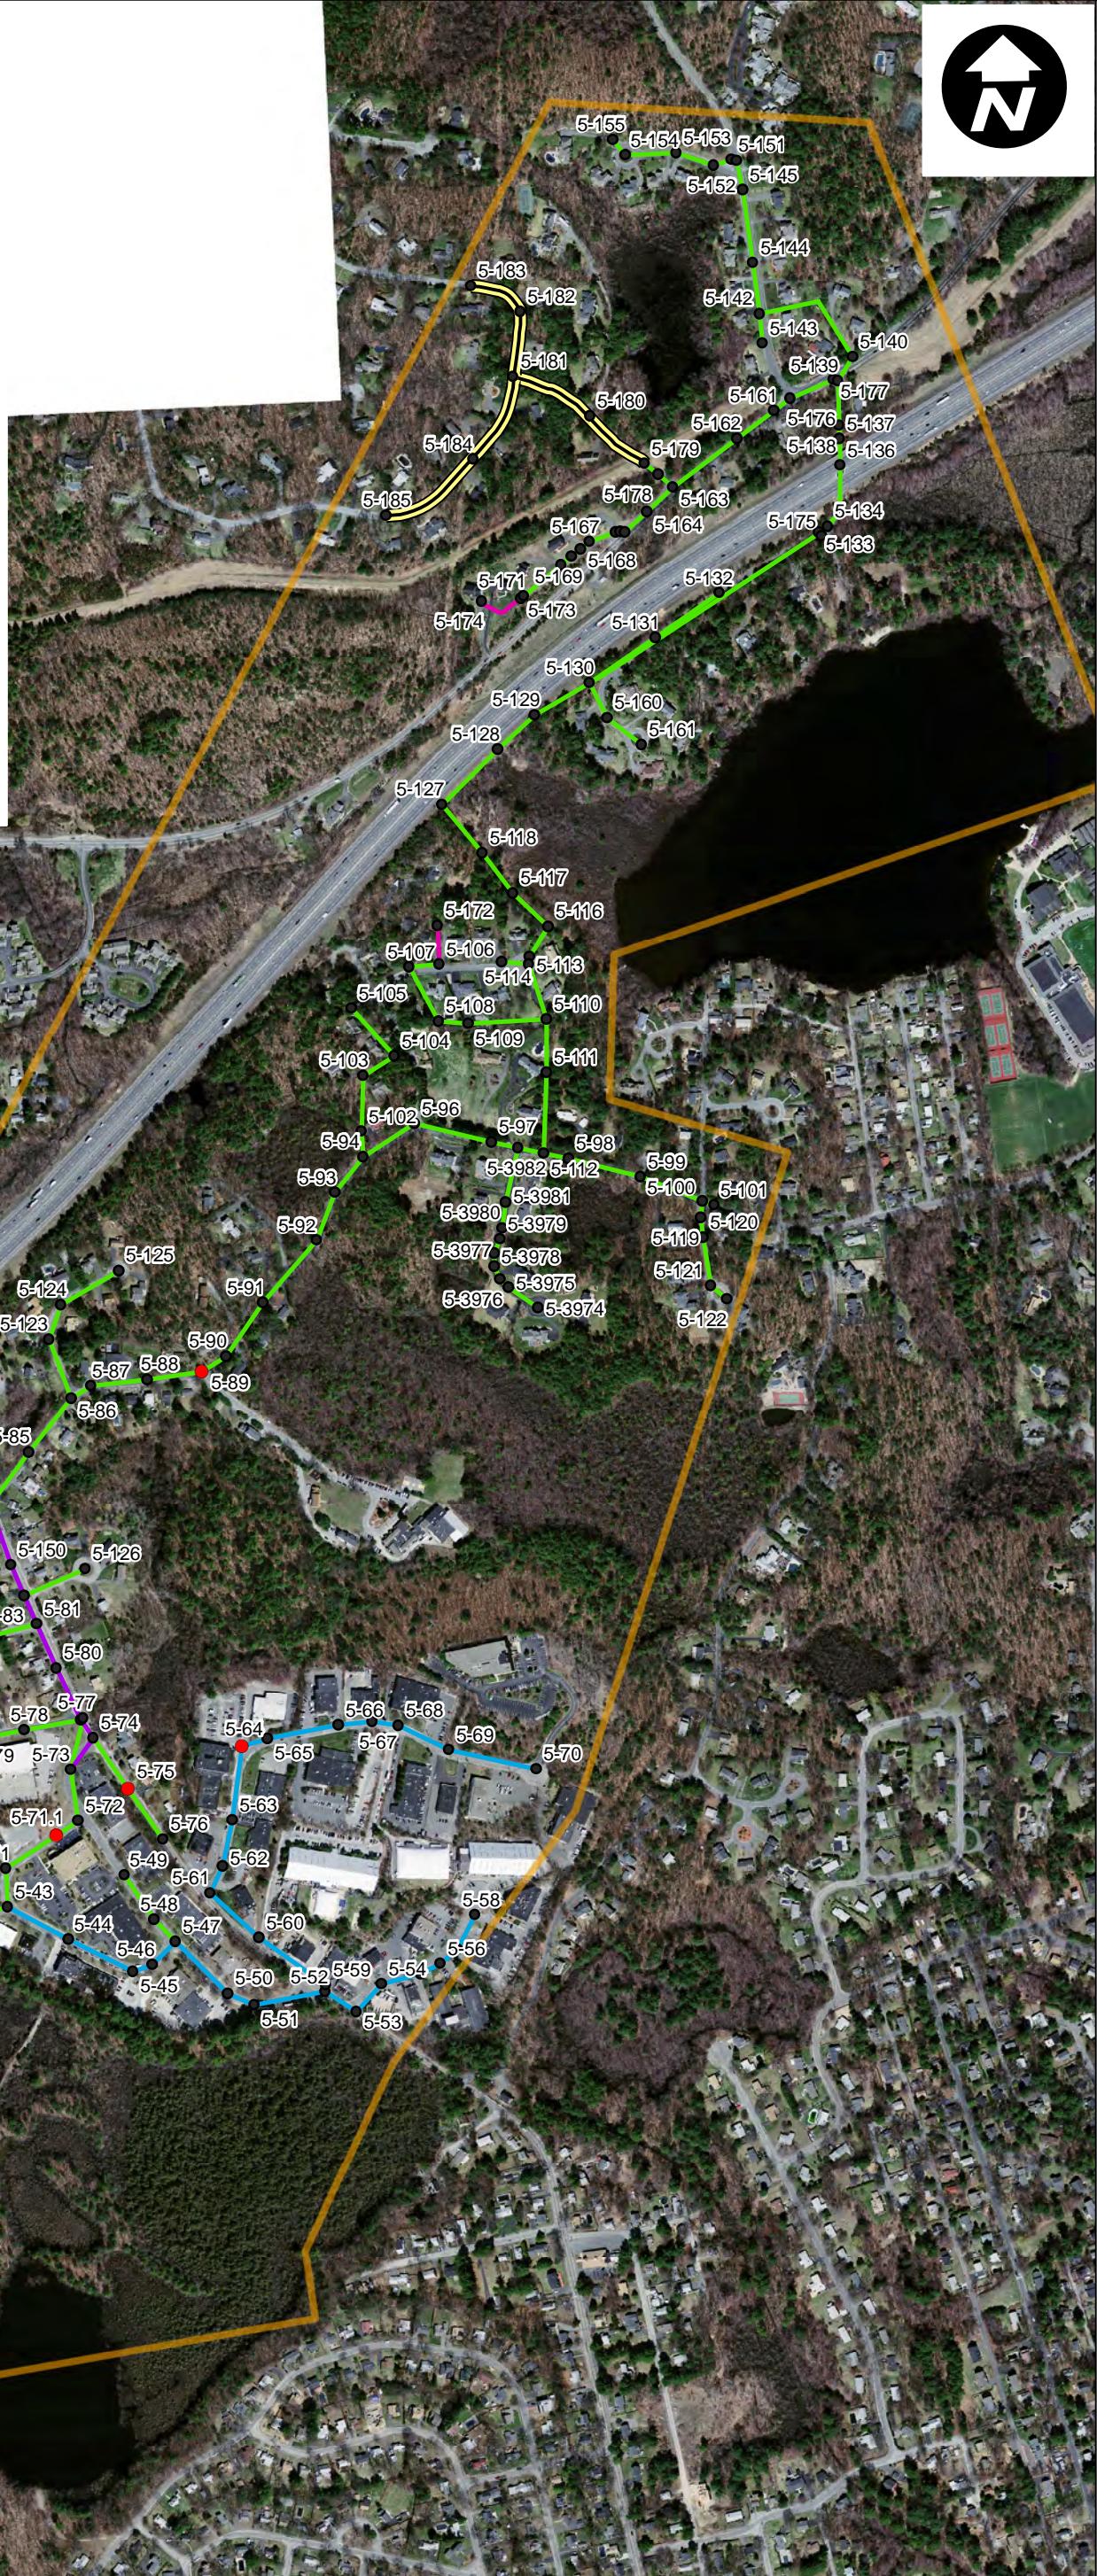

BASIN
5


SHEET NO.:	5 of 20	CHECKED	DATE	BY
CONTRACT NO.:	S-162			
SCALE:	1:7,800	REVISED	DATE	BY
DATE DRAWN:	JUNE, 2020			
DRAWN BY:	LJC			
FILE NO.:	NAT427_BSN_5.MXD			

Haley and Ward, Inc
a division of CES, Inc.
63 GREAT ROAD, SUITE 200,
MAYNARD, MASSACHUSETTS 01754-2097
PHONE: (978) 648-6025
FAX: (978) 648-6068
www.haleyward.com

DEPARTMENT OF PUBLIC WORKS
NATICK, MASSACHUSETTS

ADDENDUM
NO. 1

**3 YEAR SEWER
REHABILITATION**

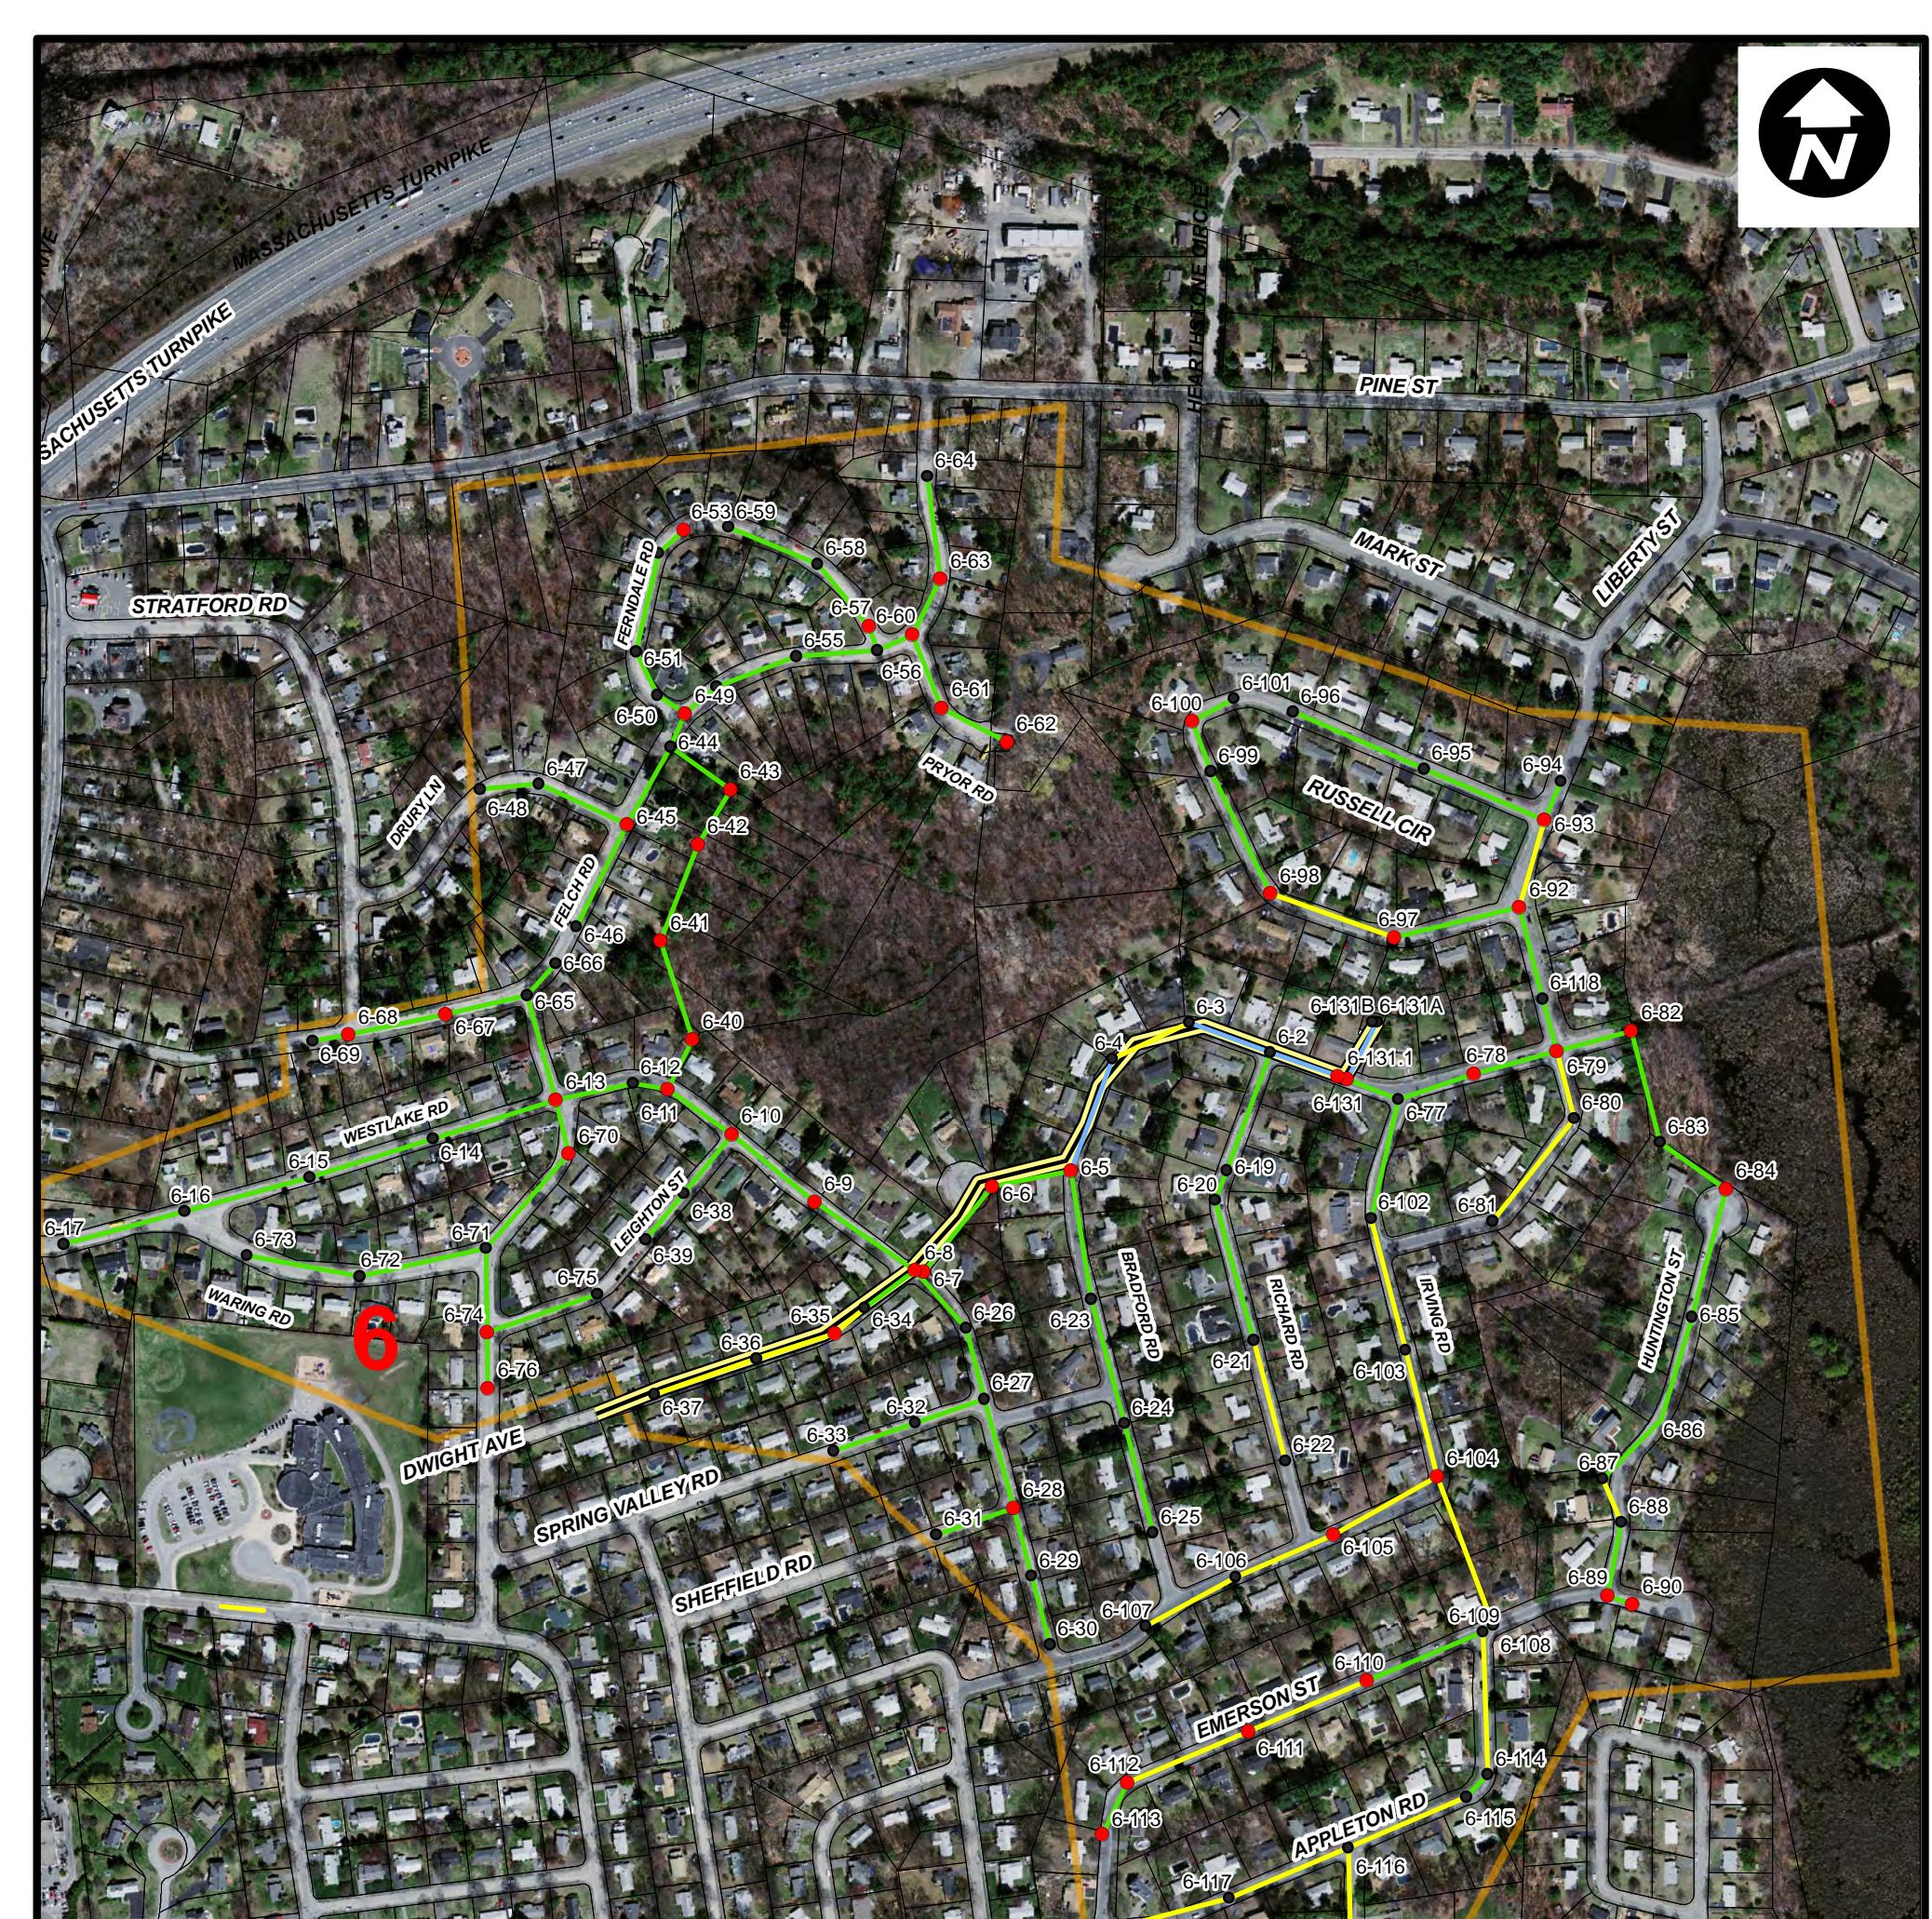

Legend

Sewer Line

— Other

Contract Work

● MANHOLES

● WORK REQUIRED

— PIPES REQUIRING REPAIR

Pipe Size

— 8"

— 10"

— 12"

Force Main


Notes:

Parcel Source: Office of Geographic Information (MassGIS), Commonwealth of Massachusetts, Information Technology Division

Sewer Manhole Source: Town of Natick GIS Department. Some sewer manhole locations are approximate.

Sewer Lines Source: Town of Natick GIS Department.

600 300 0 600
Feet

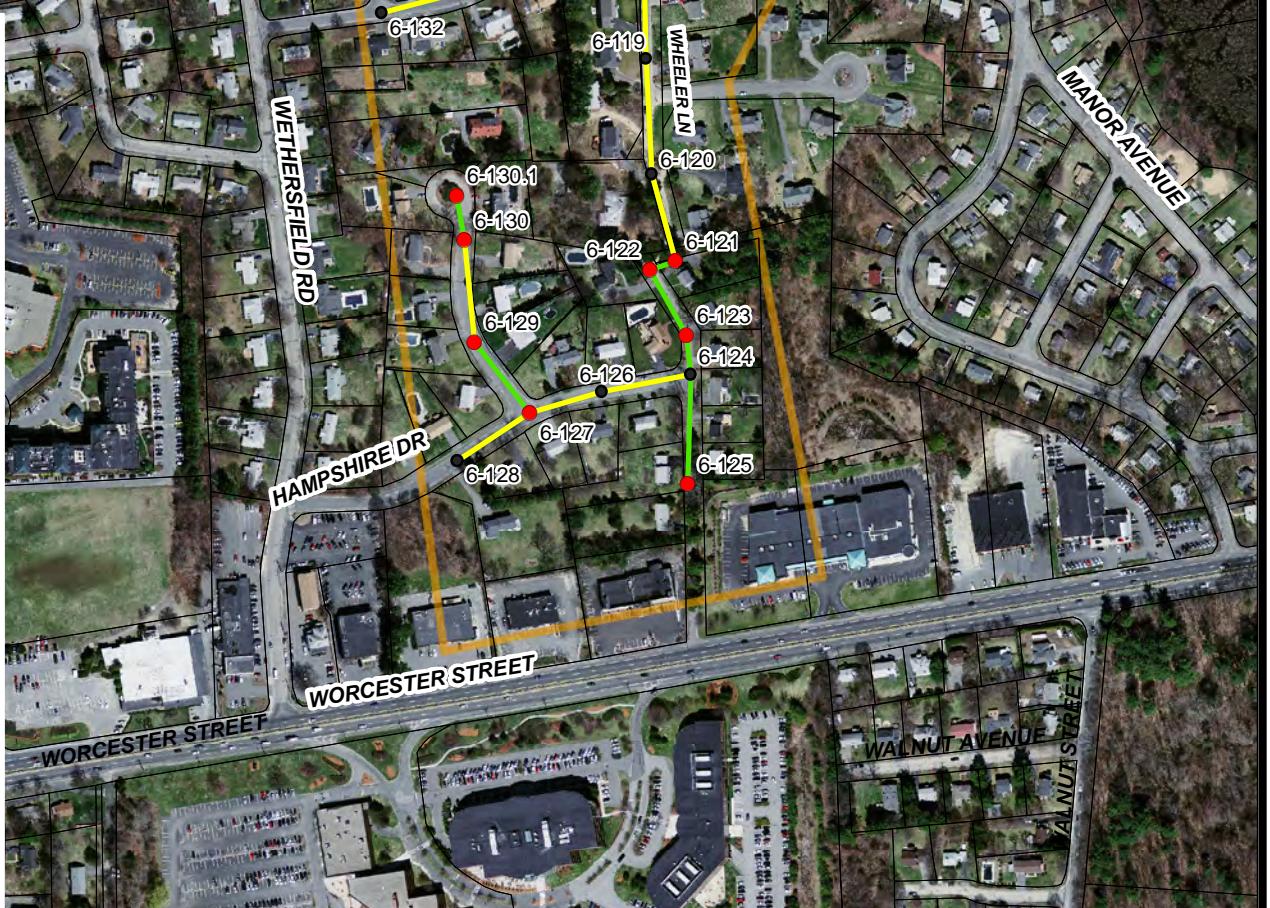

BASIN
6


SHEET NO.:	6 of 20	CHECKED	DATE	BY
CONTRACT NO.:	S-162			
SCALE:	1:5000	REVISED	DATE	BY
DATE DRAWN:	JUNE, 2020			
DRAWN BY:	LJC			
FILE NO.:	NAT427_BSN_6.MXD			

Haley and Ward, Inc
a division of CES, Inc.
63 GREAT ROAD, SUITE 200,
MAYNARD, MASSACHUSETTS 01754-2097
PHONE: (978) 648-6025
FAX: (978) 648-6068
www.haleyward.com

DEPARTMENT OF PUBLIC WORKS
NATICK, MASSACHUSETTS

ADDENDUM
NO. 1

**3 YEAR SEWER
REHABILITATION**

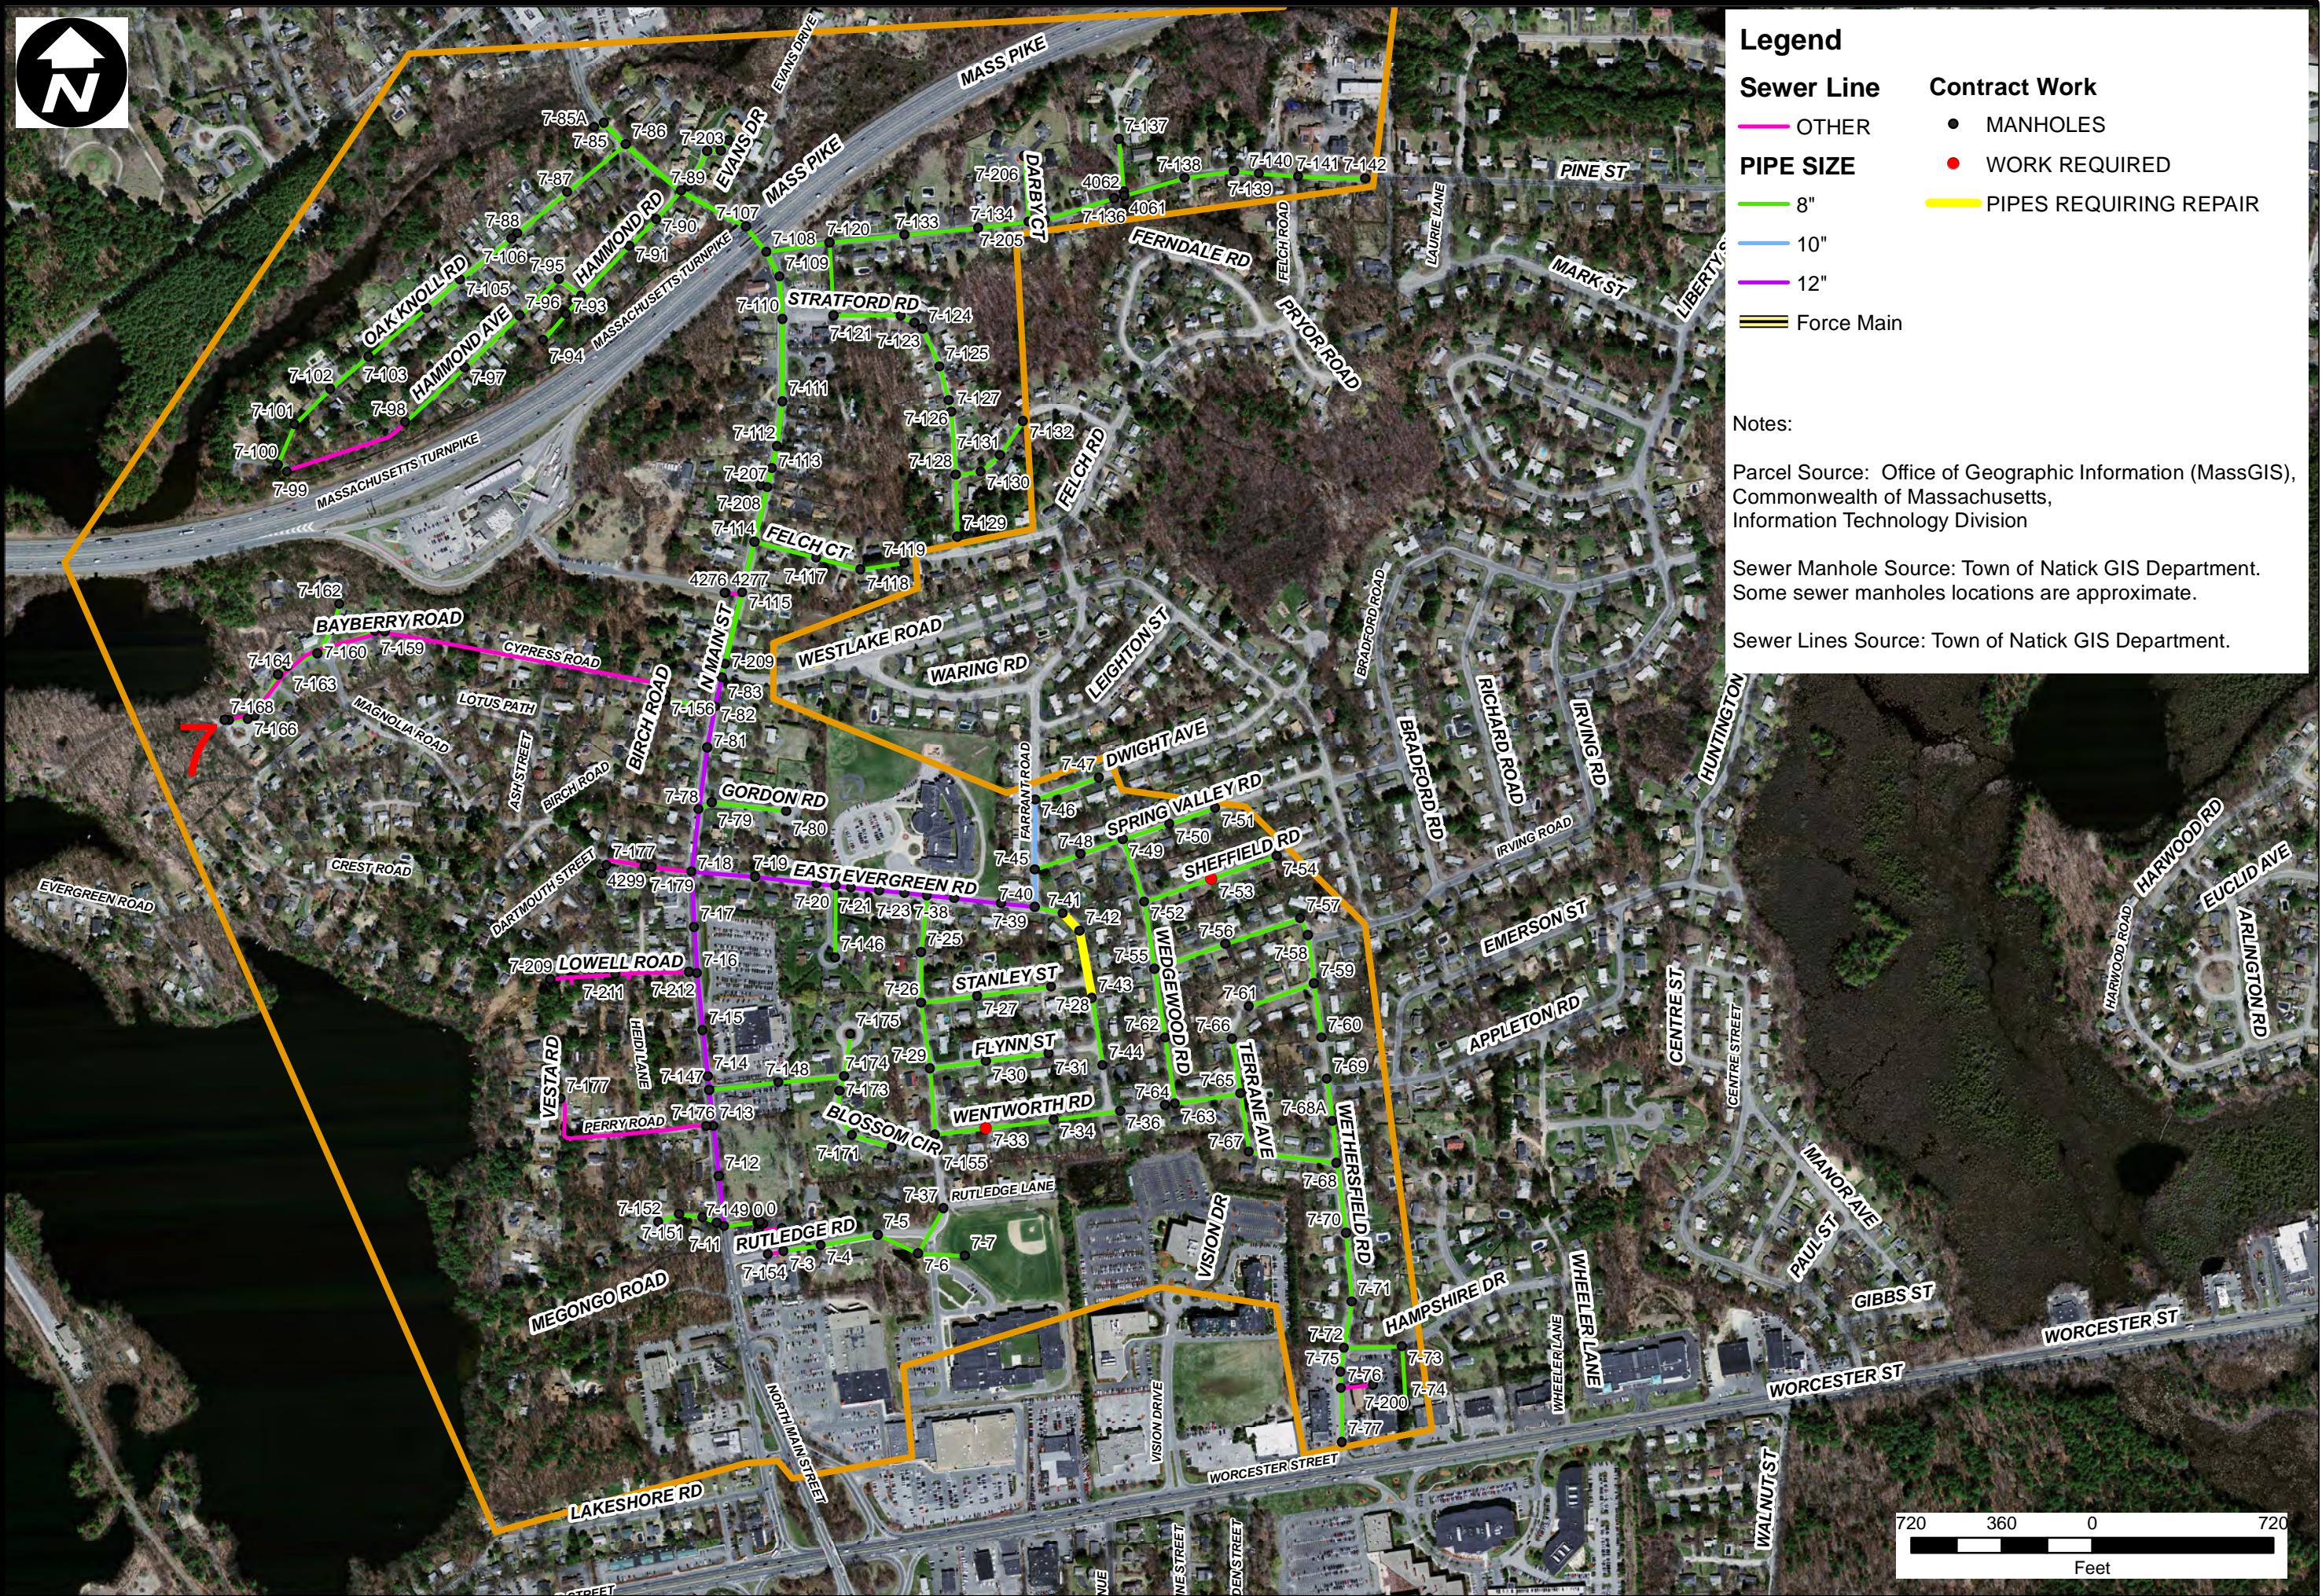

DEPARTMENT OF PUBLIC WORKS
NATICK, MASSACHUSETTS
3 YEAR SEWER REHABILITATION


ADDENDUM
NO. 1

Haley and Ward, Inc.
A division of CES Inc.
63 GREAT ROAD, SUITE 200,
MAYNARD, MASSACHUSETTS 01754-2097
PHONE: (978) 648-8025
FAX: (978) 648-8068
www.haleyward.com

SHEET NO.:	7 of 20	CHECKED	DATE	BY
CONTRACT NO.:	S-162	REVISED	DATE	BY
SCALE:	1:7200			
DATE DRAWN:	JUNE, 2020			
DRAWN BY:	LJC			

FILE NO.: NAT427_BSN_7.MXD

7

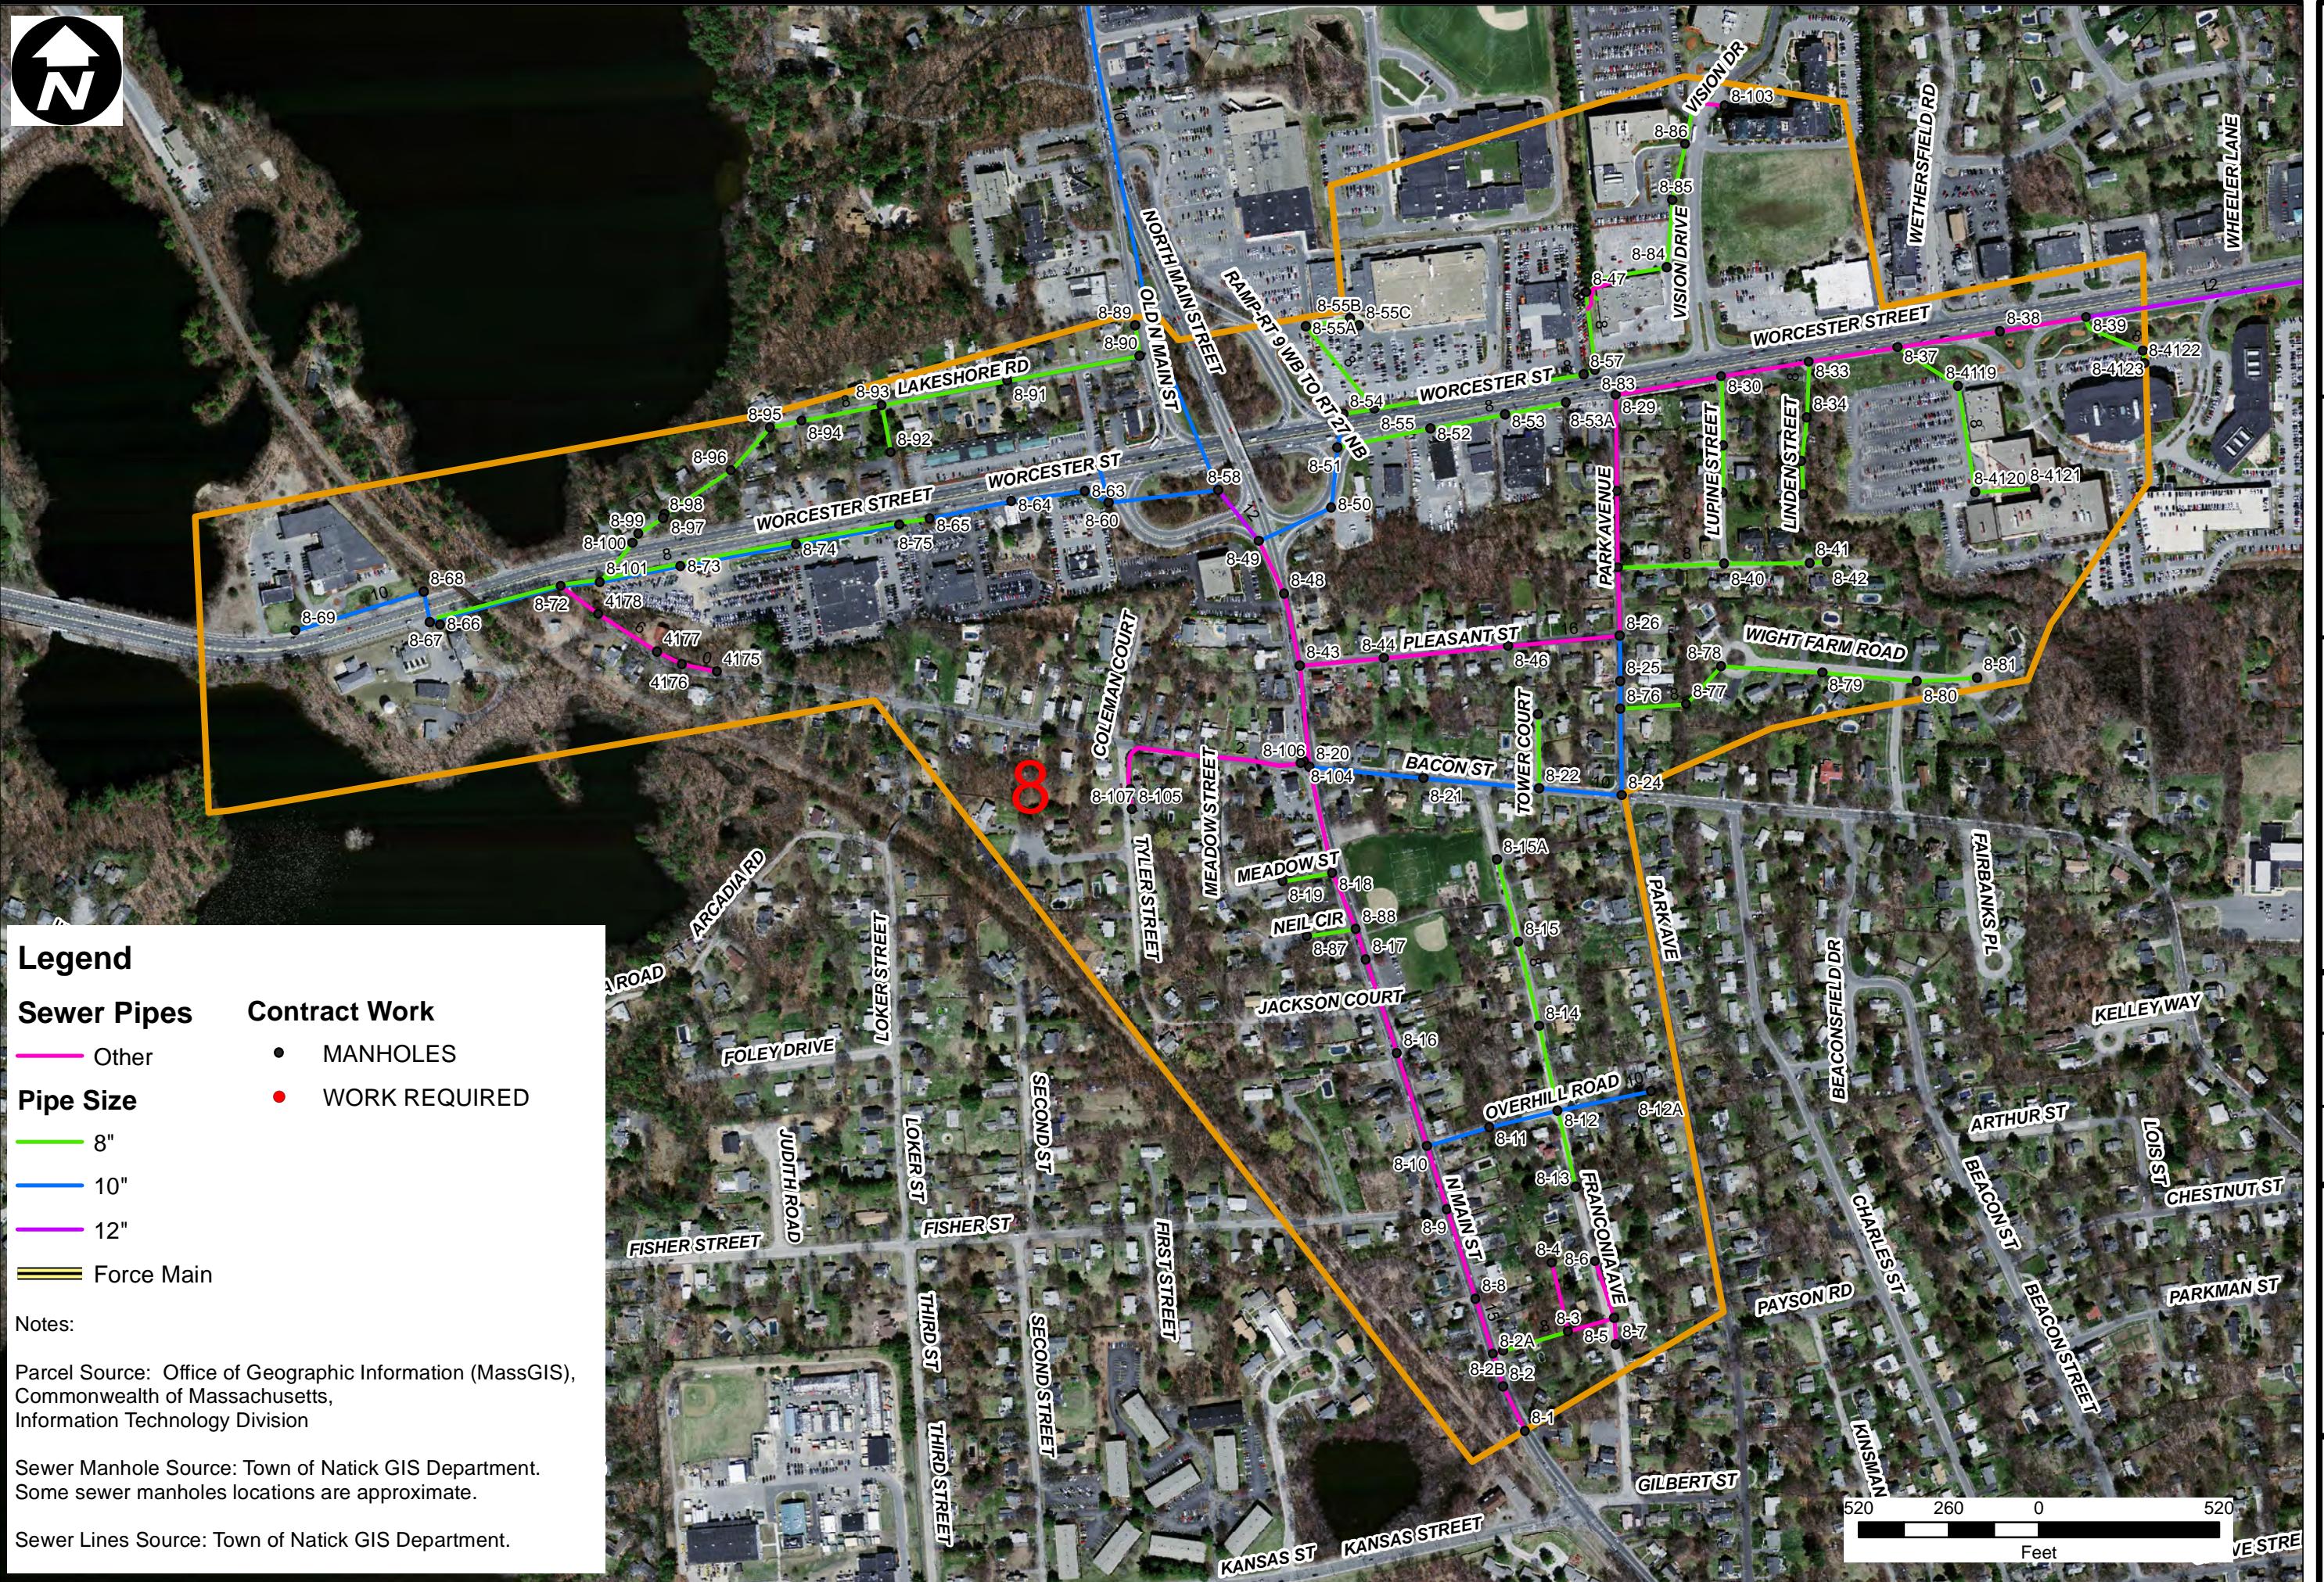

DEPARTMENT OF PUBLIC WORKS
NATICK, MASSACHUSETTS
3 YEAR SEWER REHABILITATION

ADDENDUM NO. 1

Haley and Ward, Inc.
A division of CES Inc.
68 GREAT ROAD, SUITE 200,
MAYNARD, MASSACHUSETTS 01754-2097
PHONE: (978) 648-8025
FAX: (978) 648-8668
www.haleyward.com

BASIN
OO

DEPARTMENT OF PUBLIC WORKS
NATICK, MASSACHUSETTS
3 YEAR SEWER REHABILITATION

ADDENDUM NO. 1

Haley and Ward, Inc.
A division of CES Inc.
68 GREAT ROAD, SUITE 200,
MAYNARD, MASSACHUSETTS 01754-2097
PHONE: (978) 648-8025
FAX: (978) 648-8668
www.haleyward.com


DEPARTMENT OF PUBLIC WORKS
NATICK, MASSACHUSETTS
3 YEAR SEWER REHABILITATION

ADDENDUM NO. 1

Haley and Ward, Inc.
A division of CES Inc.
68 GREAT ROAD, SUITE 200,
MAYNARD, MASSACHUSETTS 01754-2097
PHONE: (978) 648-8025
FAX: (978) 648-8668
www.haleyward.com



LER STREET

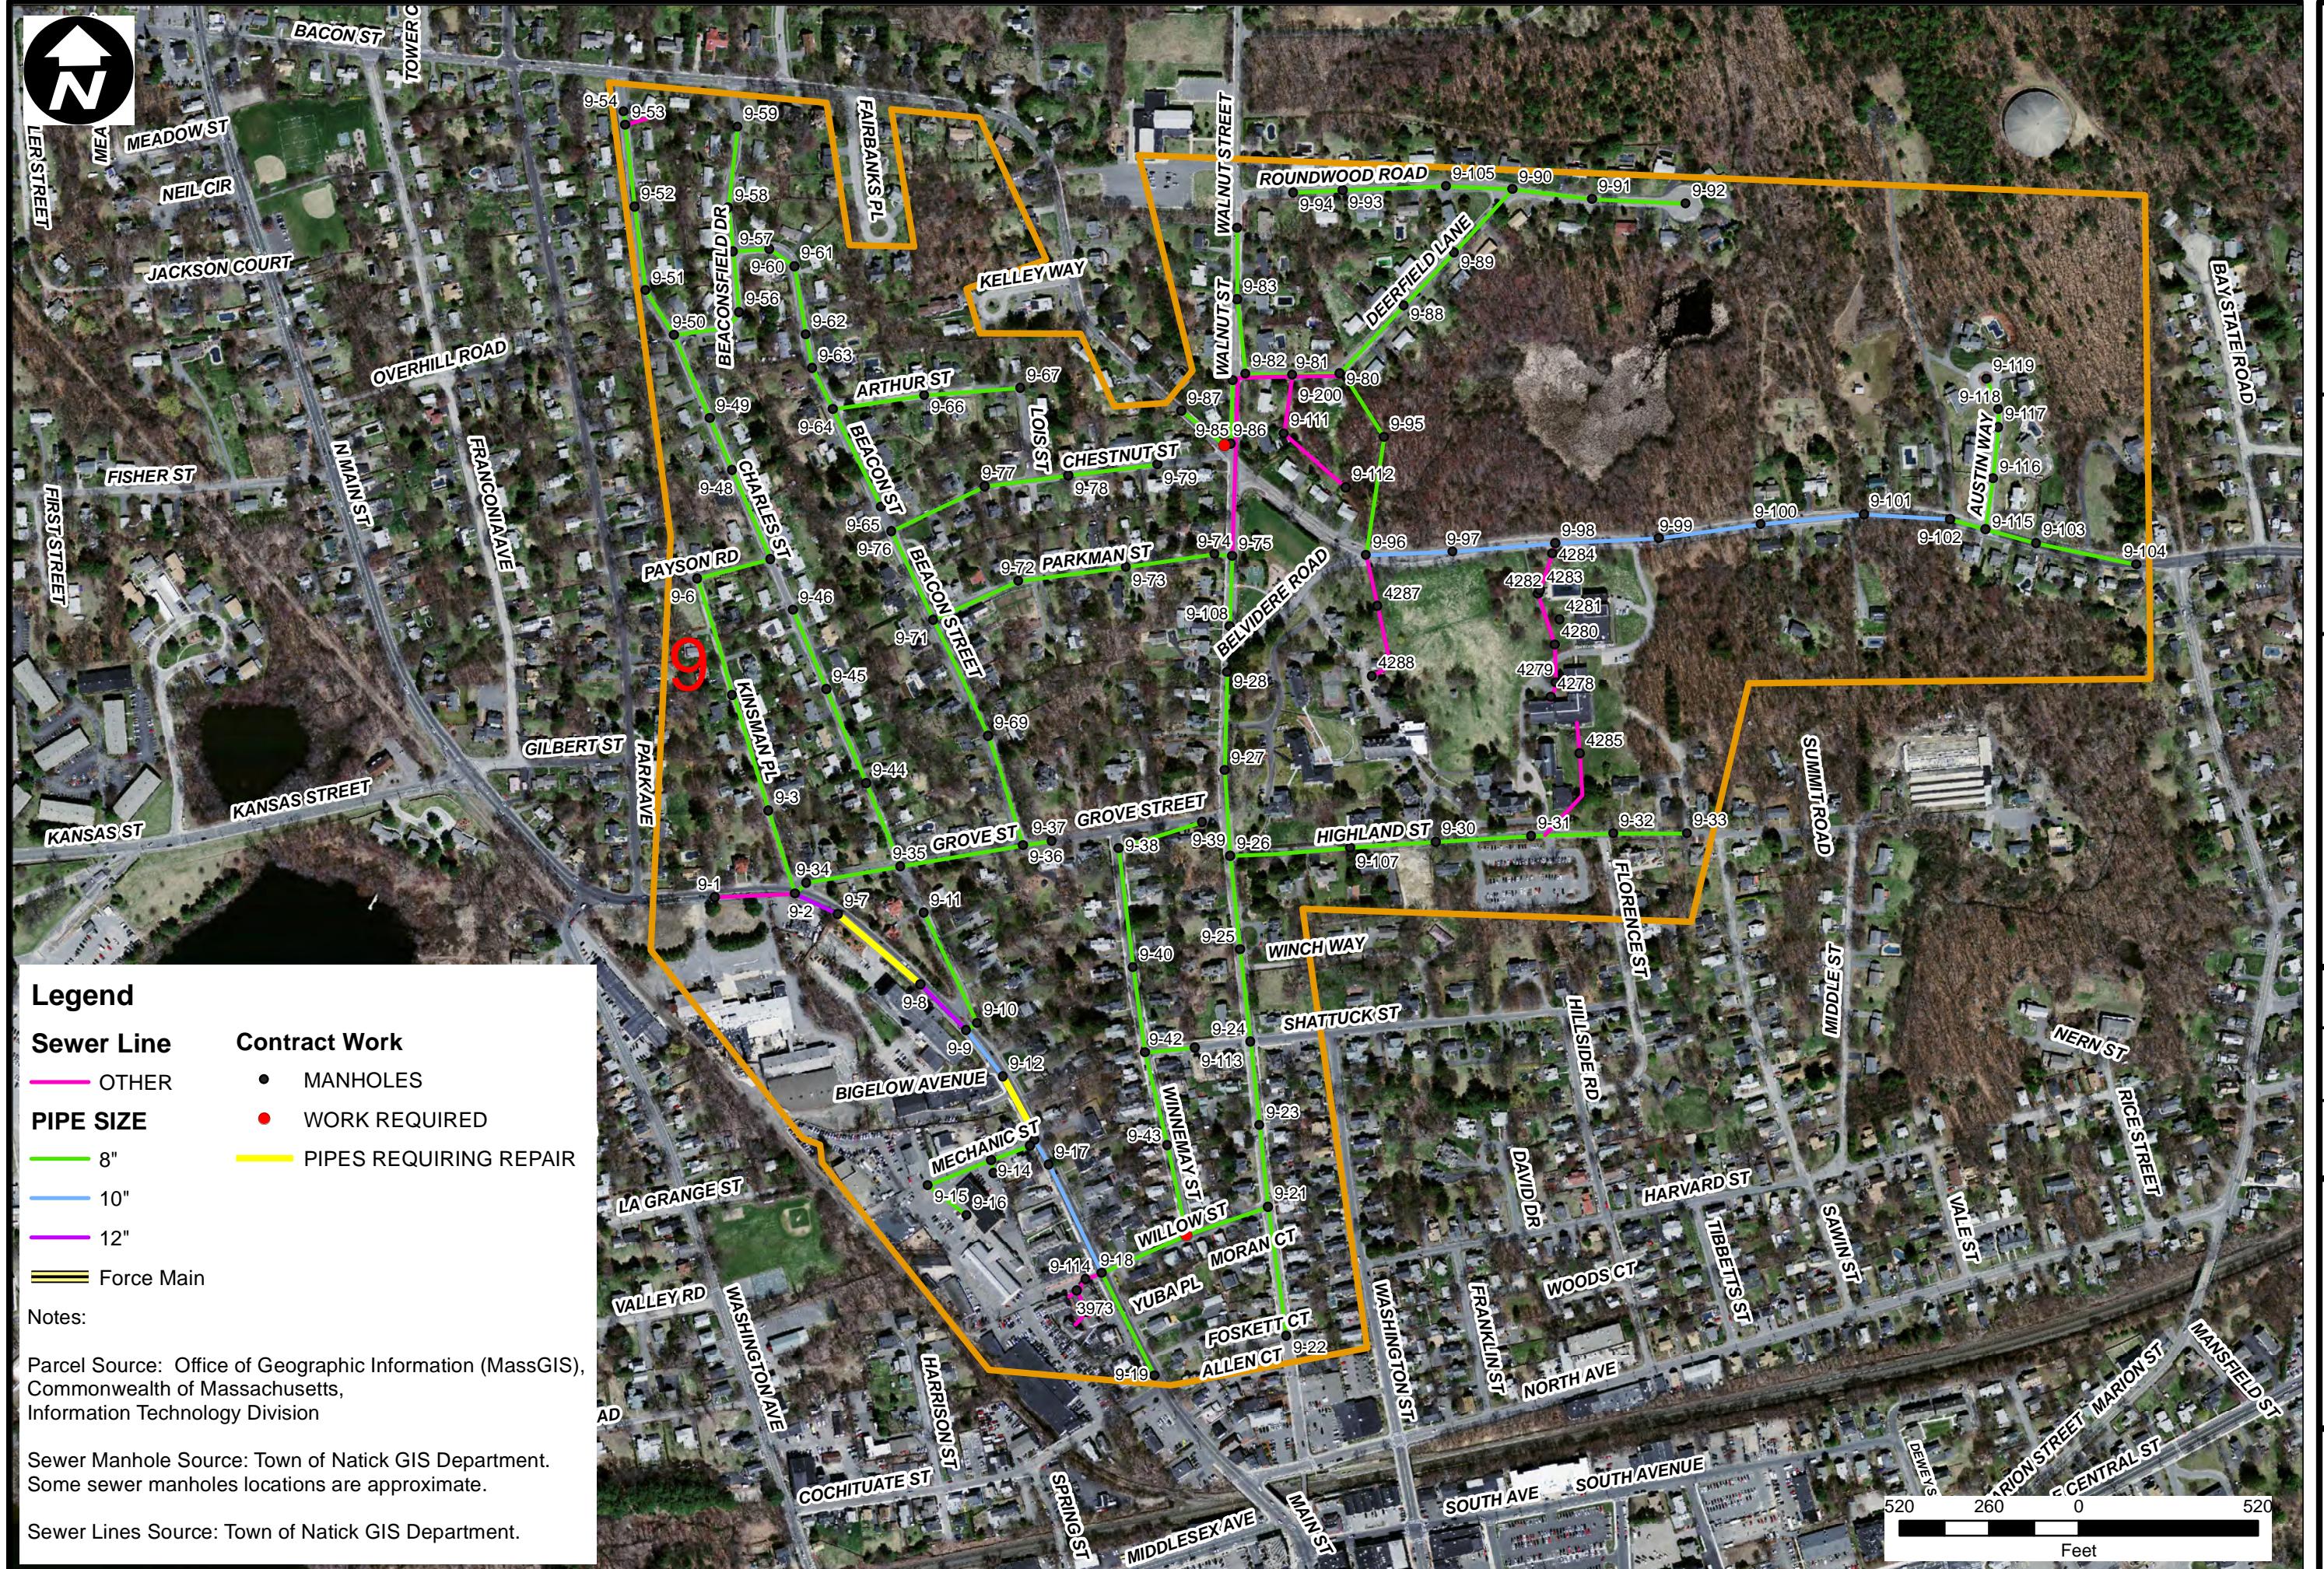

DEPARTMENT OF PUBLIC WORKS
NATICK, MASSACHUSETTS
3 YEAR SEWER REHABILITATION

**ADDENDUM
NO. 1**

**Haley and Ward, Inc.
A division of CES Inc.**
68 GREAT ROAD, SUITE 200,
MAYNARD, MASSACHUSETTS 01754-2097
PHONE: (978) 648-8025
FAX: (978) 648-8068
www.haleyward.com

SHEET NO.:	9 of 20	CHECKED	DATE	BY
CONTRACT NO.:	S-162	REvised	JUNE, 2020	
SCALE:	1:5,200			
DATE DRAWN:				
DRAWN BY:	LJC			
FILE NO.:	NATICK_BSN_9.MXD			

BASIN
9

Legend

Sewer Line

— OTHER

PIPE SIZE

— 8"

— 10"

— 12"

— Force Main

Contract Work

- MANHOLES

- WORK REQUIRED

— PIPES REQUIRING REPAIR



3 YEAR SEWER REHABILITATION

DEPARTMENT OF PUBLIC WORKS
NATICK, MASSACHUSETTS

ADDENDUM
NO. 1


Haley and Ward, Inc.
A division of CES Inc.
68 GREAT ROAD, SUITE 200,
MAYNARD, MASSACHUSETTS 01754-2097
PHONE: (978) 648-8025
FAX: (978) 648-8068
www.haleyward.com

Notes:

Parcel Source: Office of Geographic Information (MassGIS),
Commonwealth of Massachusetts,
Information Technology Division

Sewer Manhole Source: Town of Natick GIS Department.
Some sewer manholes locations are approximate.

Sewer Lines Source: Town of Natick GIS Department.

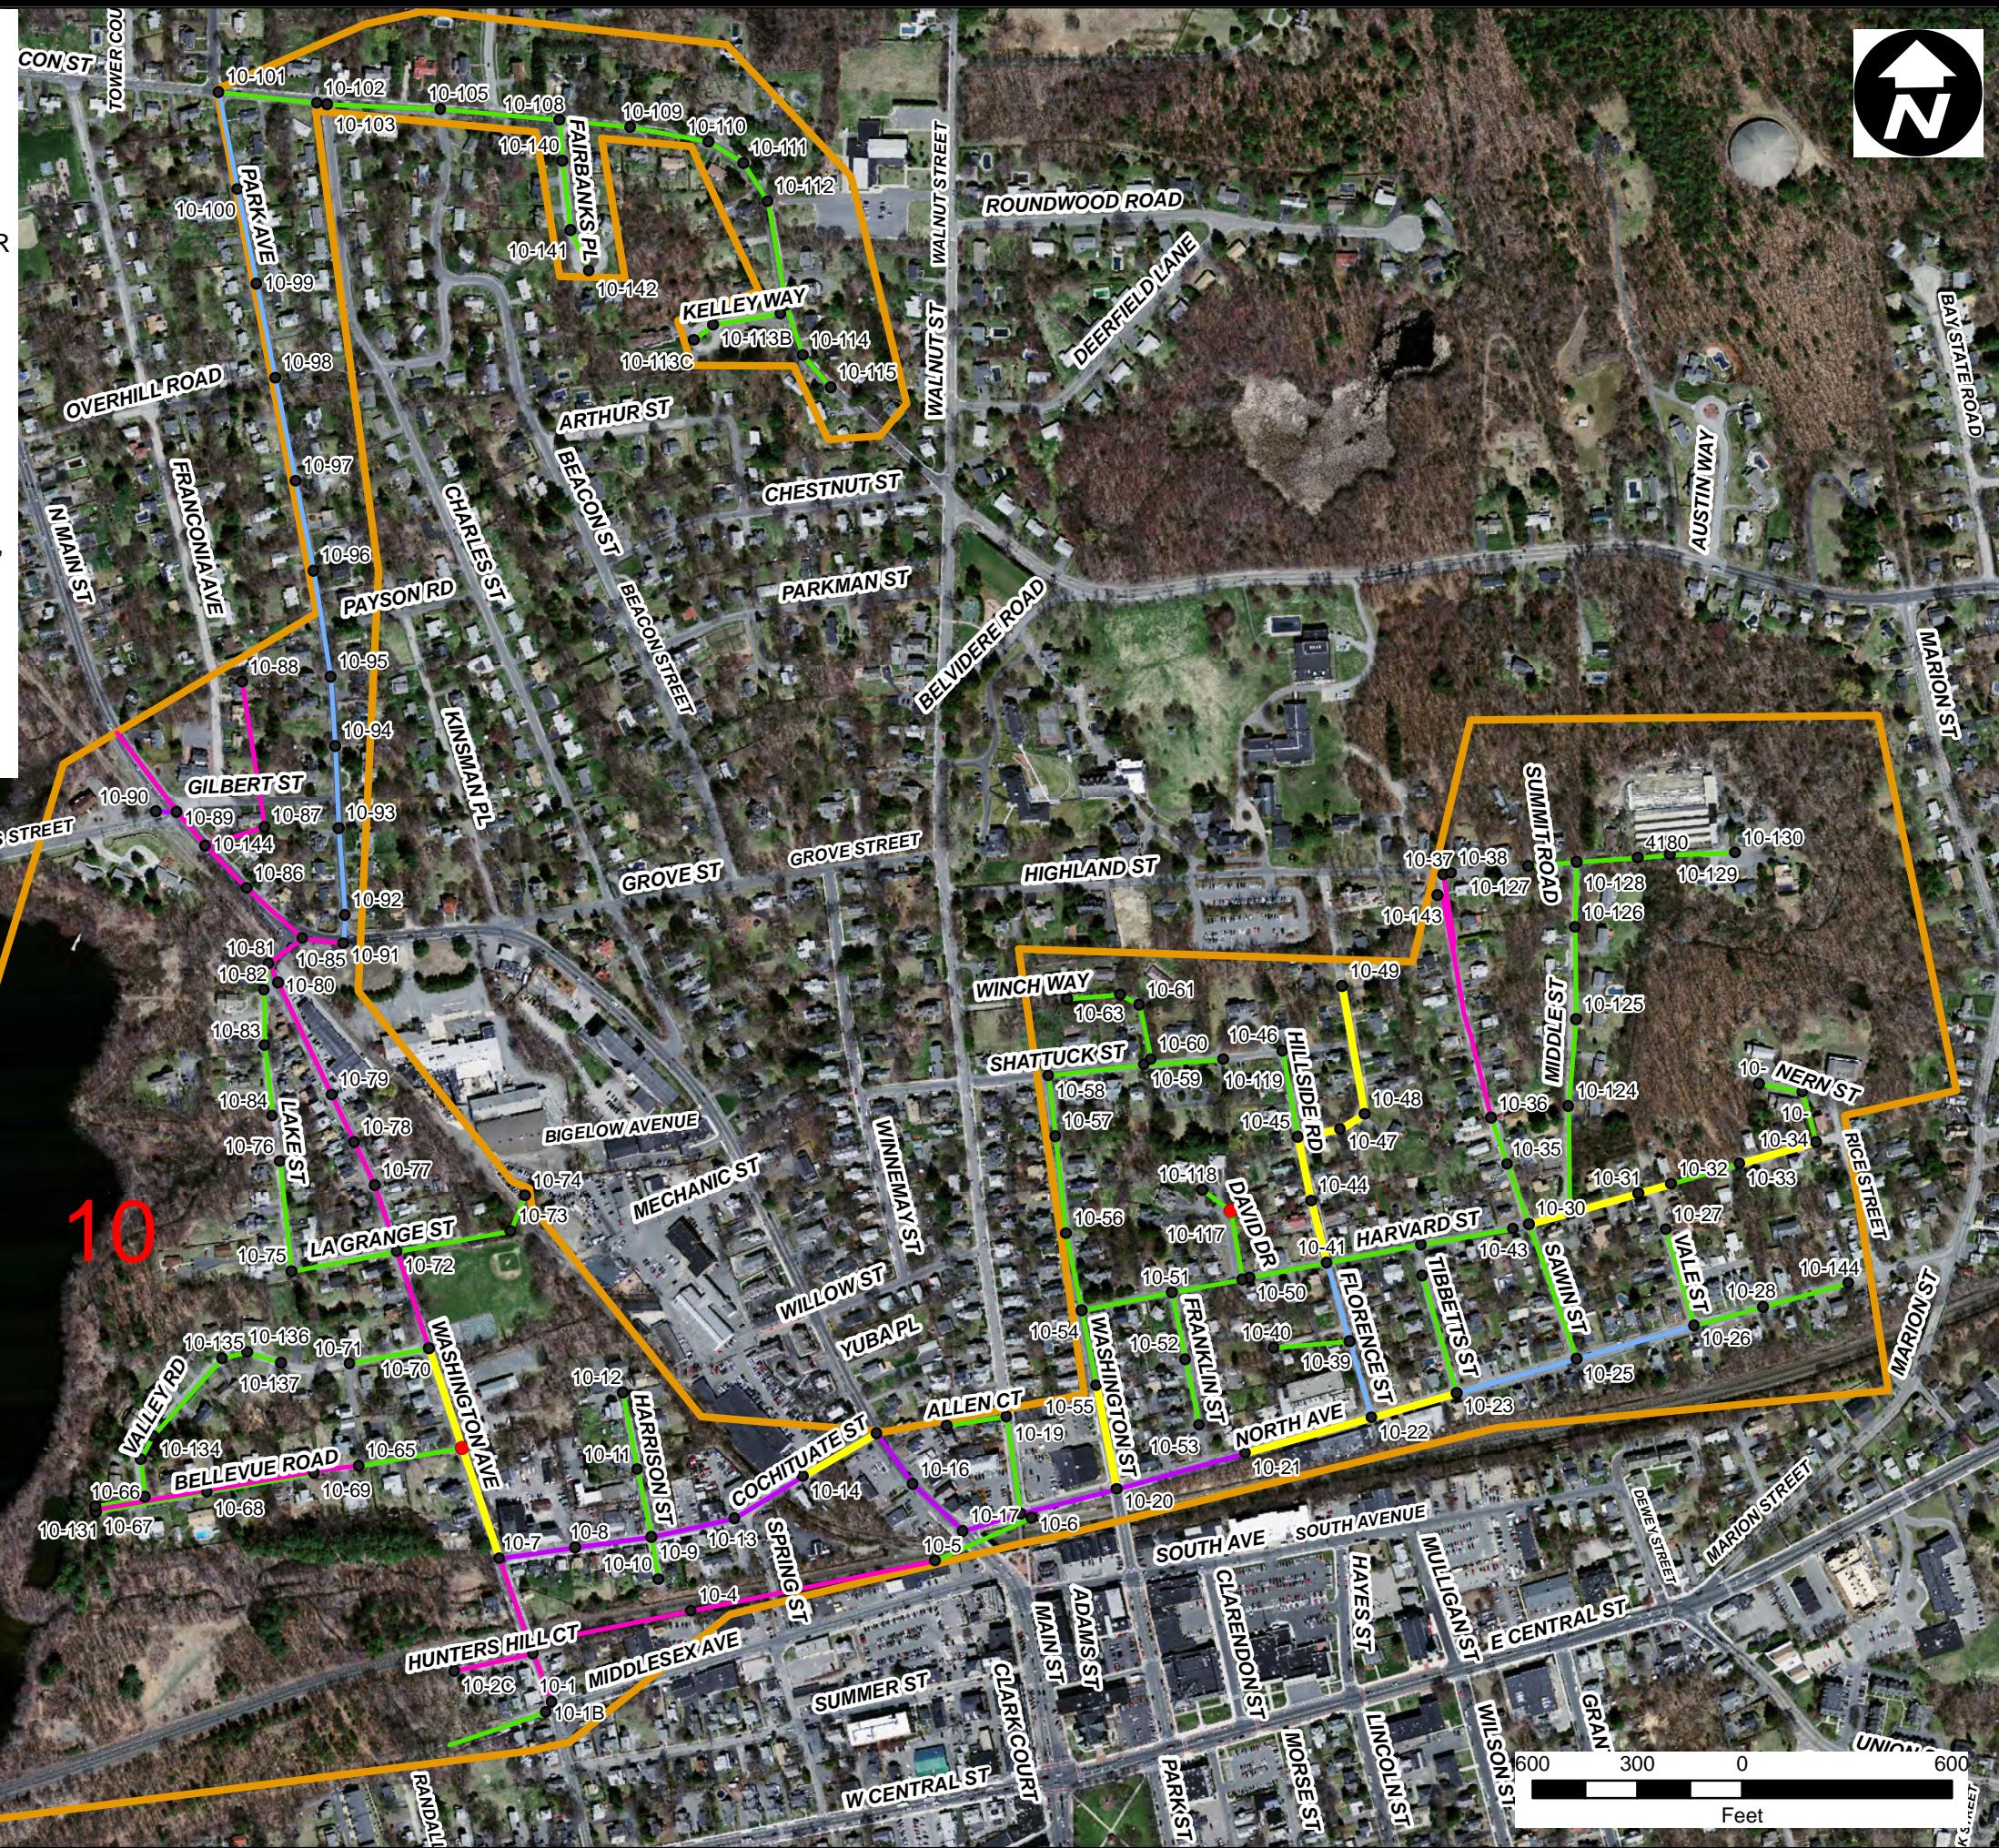



SHEET NO.:	10 of 20	CHECKED	DATE	BY
CONTRACT NO.:	S162	REVISED	DATE	BY
SCALE:	1:6,000			
DATE DRAWN:	JUNE, 2020			
DRAWN BY:	LJC			

FILE NO.: NATT427_BSN_10.MXD

BASIN

10

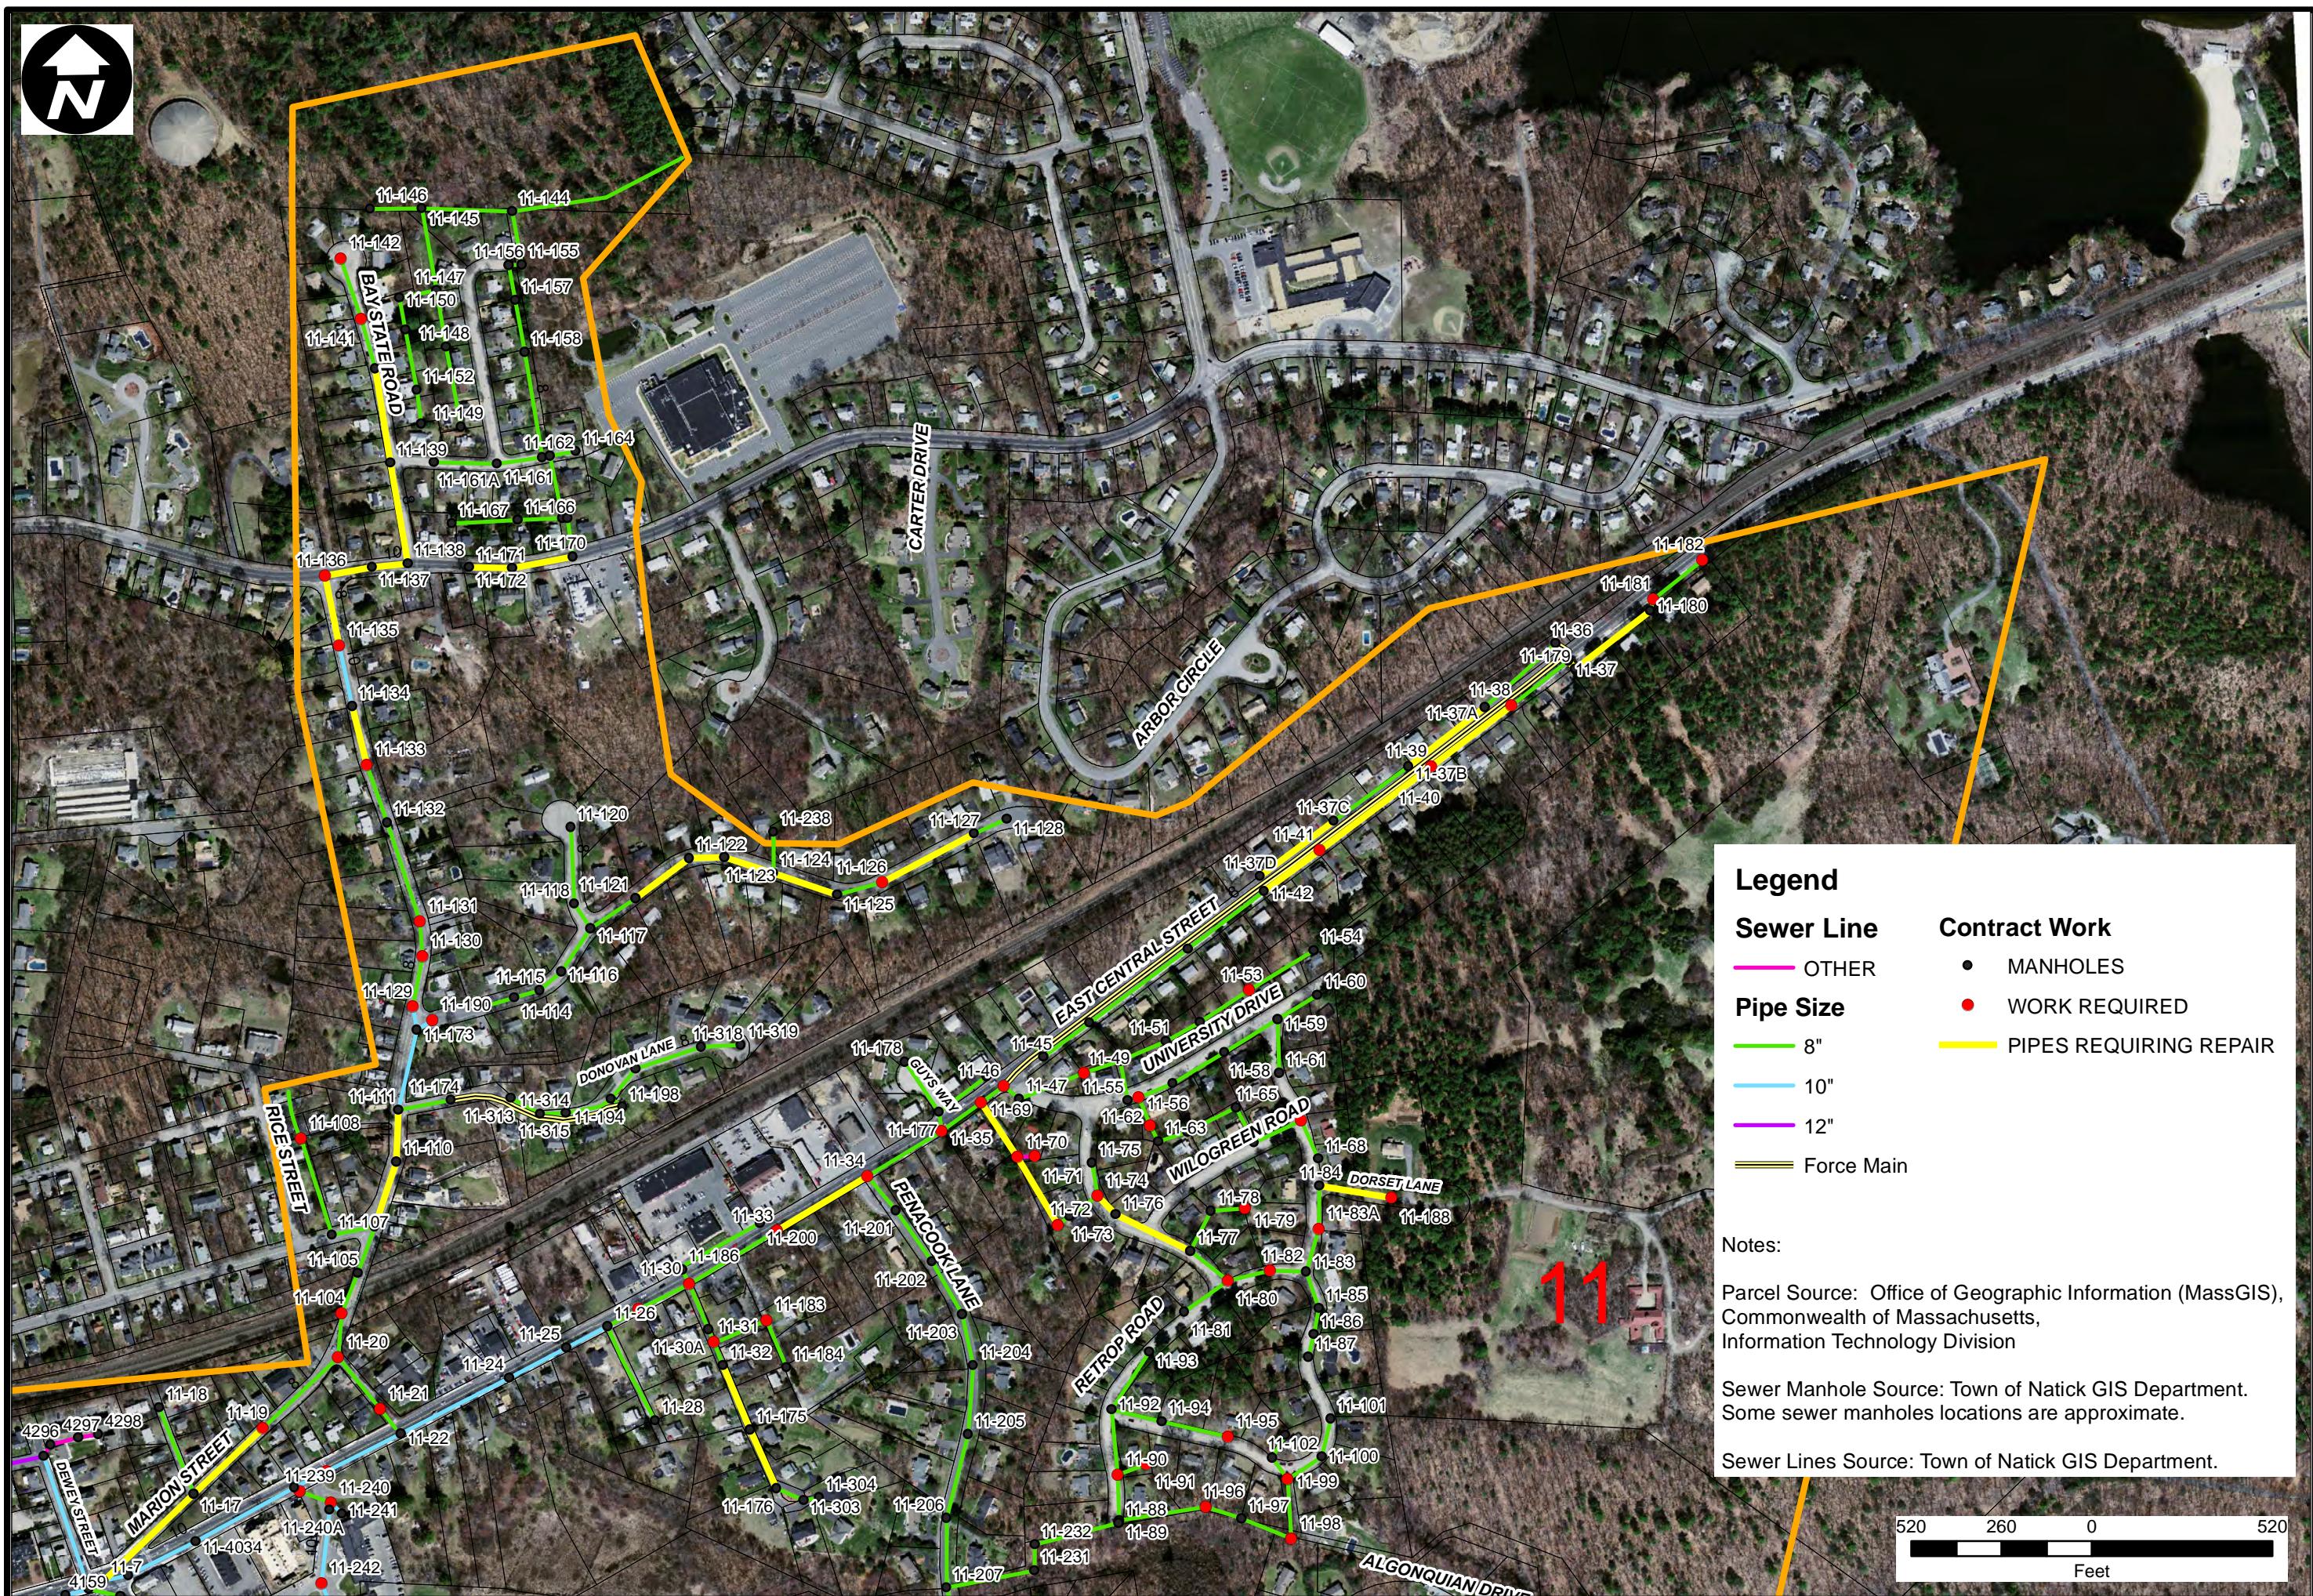

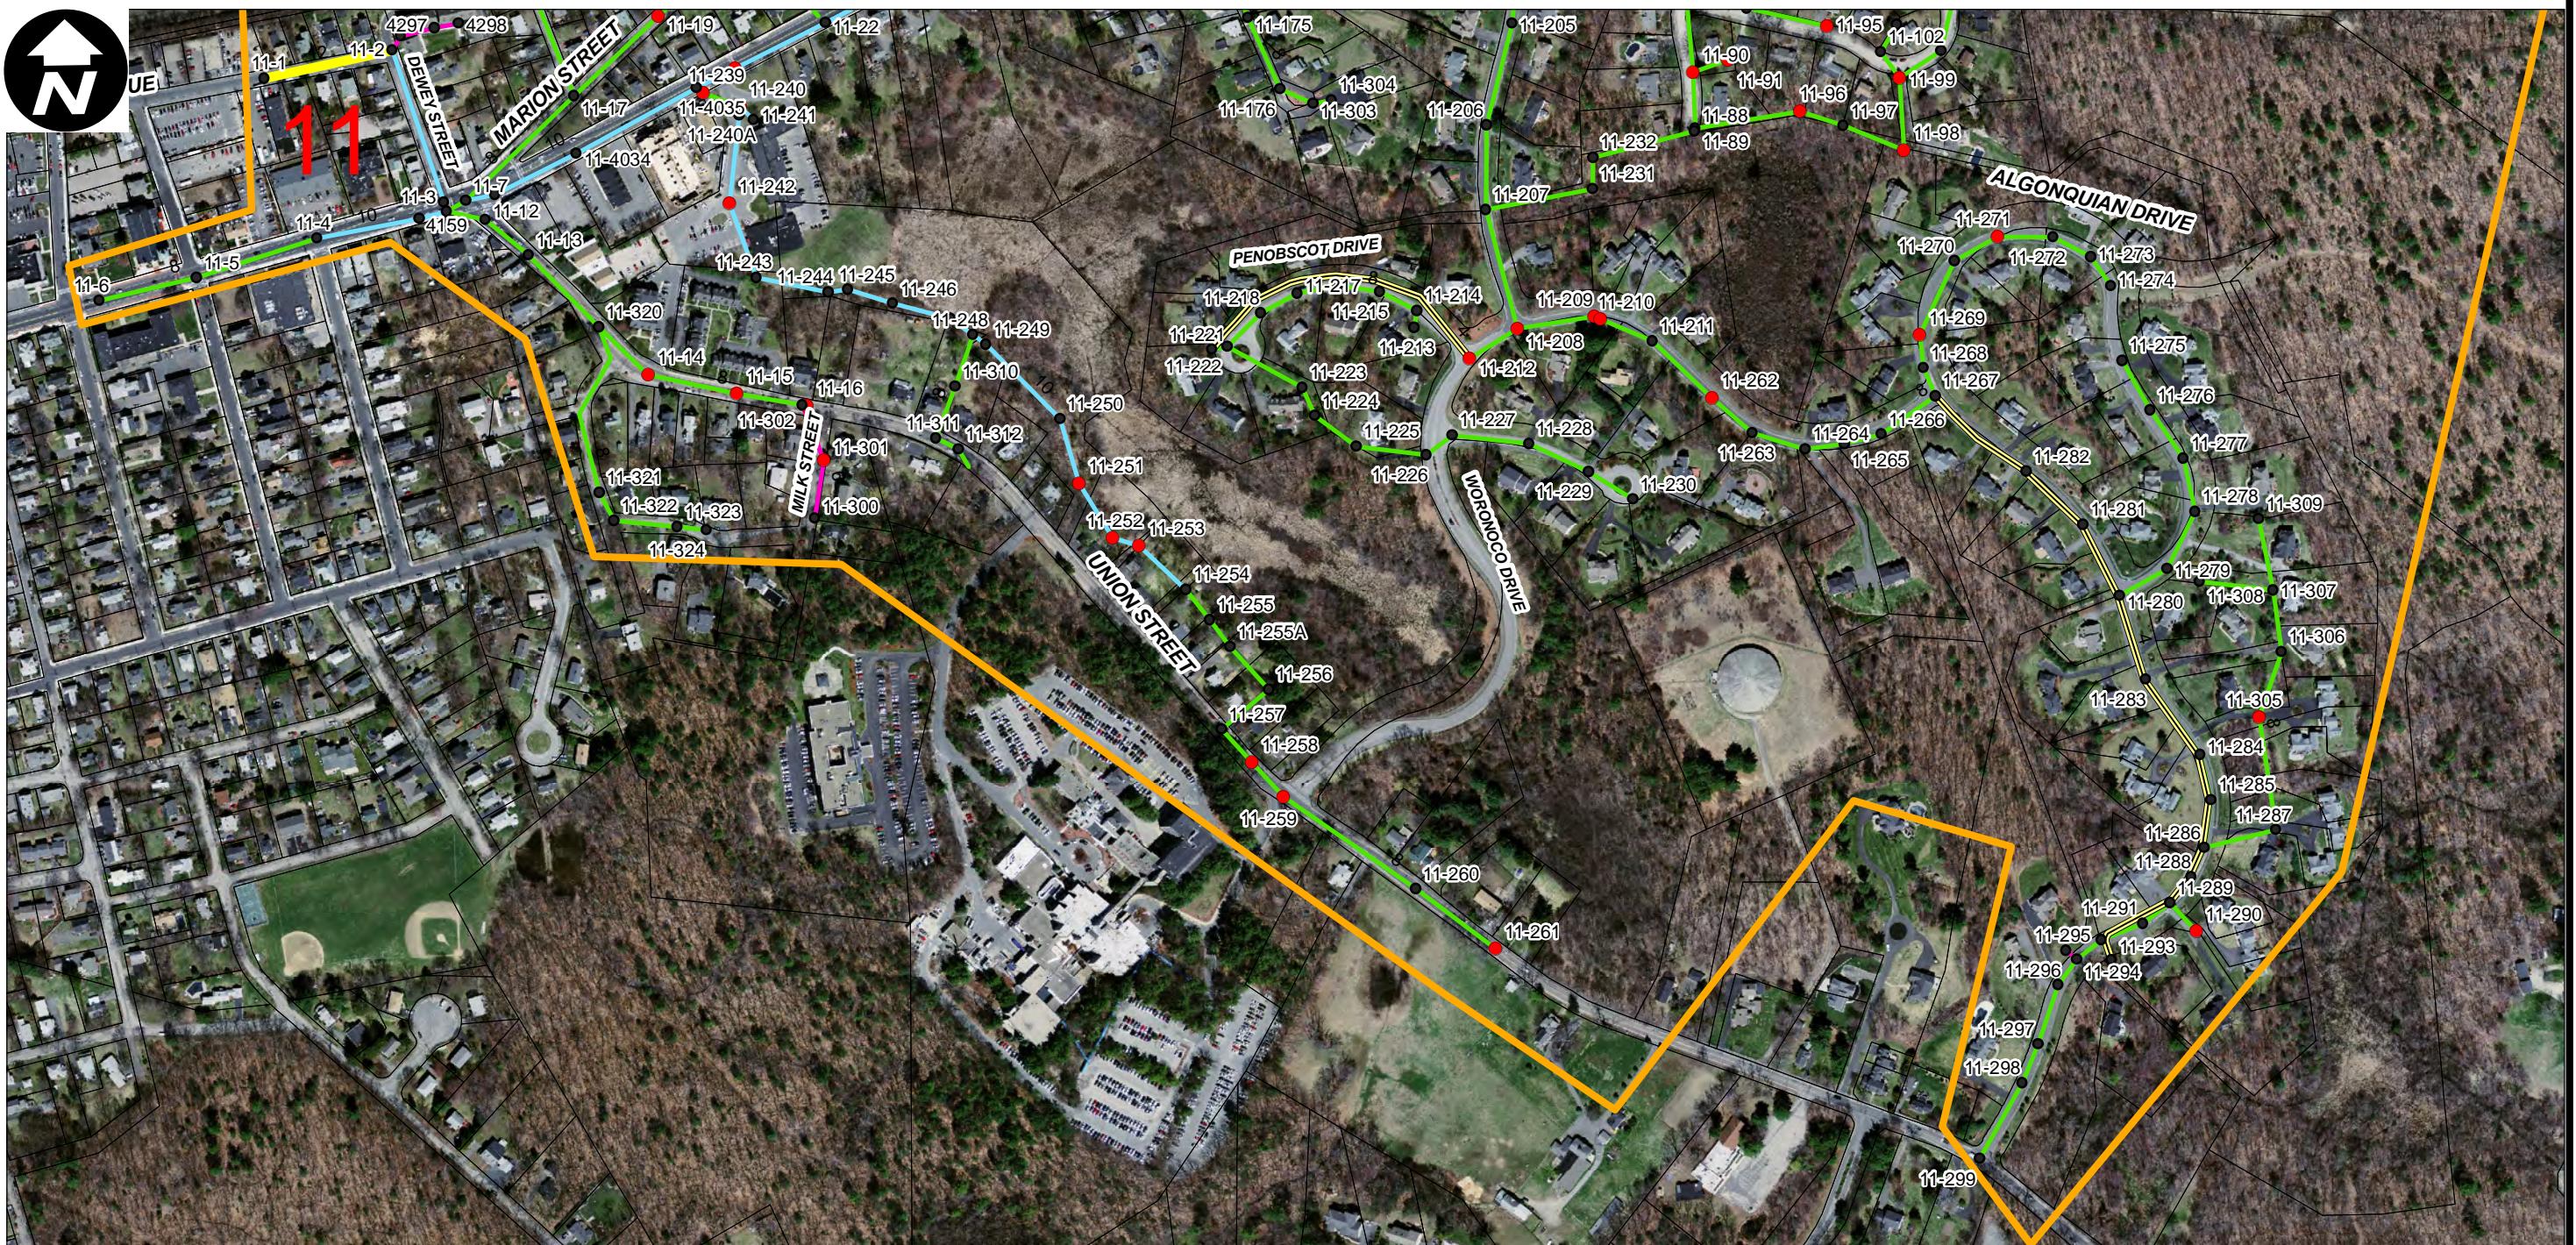

**DEPARTMENT OF PUBLIC WORKS
NATICK, MASSACHUSETTS**

**3 YEAR SEWER
REHABILITATION**

**ADDENDUM
NO. 1**

**Haley and Ward, Inc.
A division of CES Inc.**
63 GREAT ROAD, SUITE 200,
MAYNARD, MASSACHUSETTS 01754-2097
PHONE: (978) 648-8025
FAX: (978) 648-8068
www.haleyward.com

Legend

Sewer Line

— OTHER

Pipe Size

— 8"

— 10"

— 12"


— Force Main

Contract Work

● MANHOLES

● WORK REQUIRED

— PIPE REQUIRING REPAIR

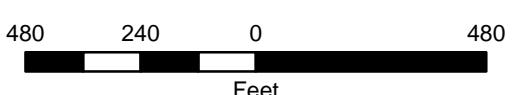

**BASIN
11S**

Notes:

Parcel Source: Office of Geographic Information (MassGIS),
Commonwealth of Massachusetts,
Information Technology Division

Sewer Manhole Source: Town of Natick GIS Department.
Some sewer manholes locations are approximate.

Sewer Lines Source: Town of Natick GIS Department.

SHEET NO.:	12 of 20	CHECKED	DATE	BY
CONTRACT NO.:	S-162	REVISED	DATE	BY
SCALE:	1:4,800			
DATE DRAWN:	JUNE, 2020			
DRAWN BY:	LJC			

FILE NO.: NATICK_BSN_11S.MXD

Legend

Sewer Line

— OTHER

Contract Work

- MANHOLES

- WORK REQUIRED

Pipe Size

— 8"

— 10"

— 12"

— Force Main

PIPES REQUIRING REPAIR



3 YEAR SEWER REHABILITATION

DEPARTMENT OF PUBLIC WORKS
NATICK, MASSACHUSETTS

ADDENDUM
NO. 1


Haley and Ward, Inc.
A division of CES Inc.
68 GREAT ROAD, SUITE 200,
NAYLARD, MASSACHUSETTS 01754-2097
PHONE: (978) 648-8025
FAX: (978) 648-8068
www.haleyward.com

Notes:

Parcel Source: Office of Geographic Information (MassGIS),
Commonwealth of Massachusetts,
Information Technology Division

Sewer Manhole Source: Town of Natick GIS Department.
Some sewer manholes locations are approximate.


Sewer Lines Source: Town of Natick GIS Department.

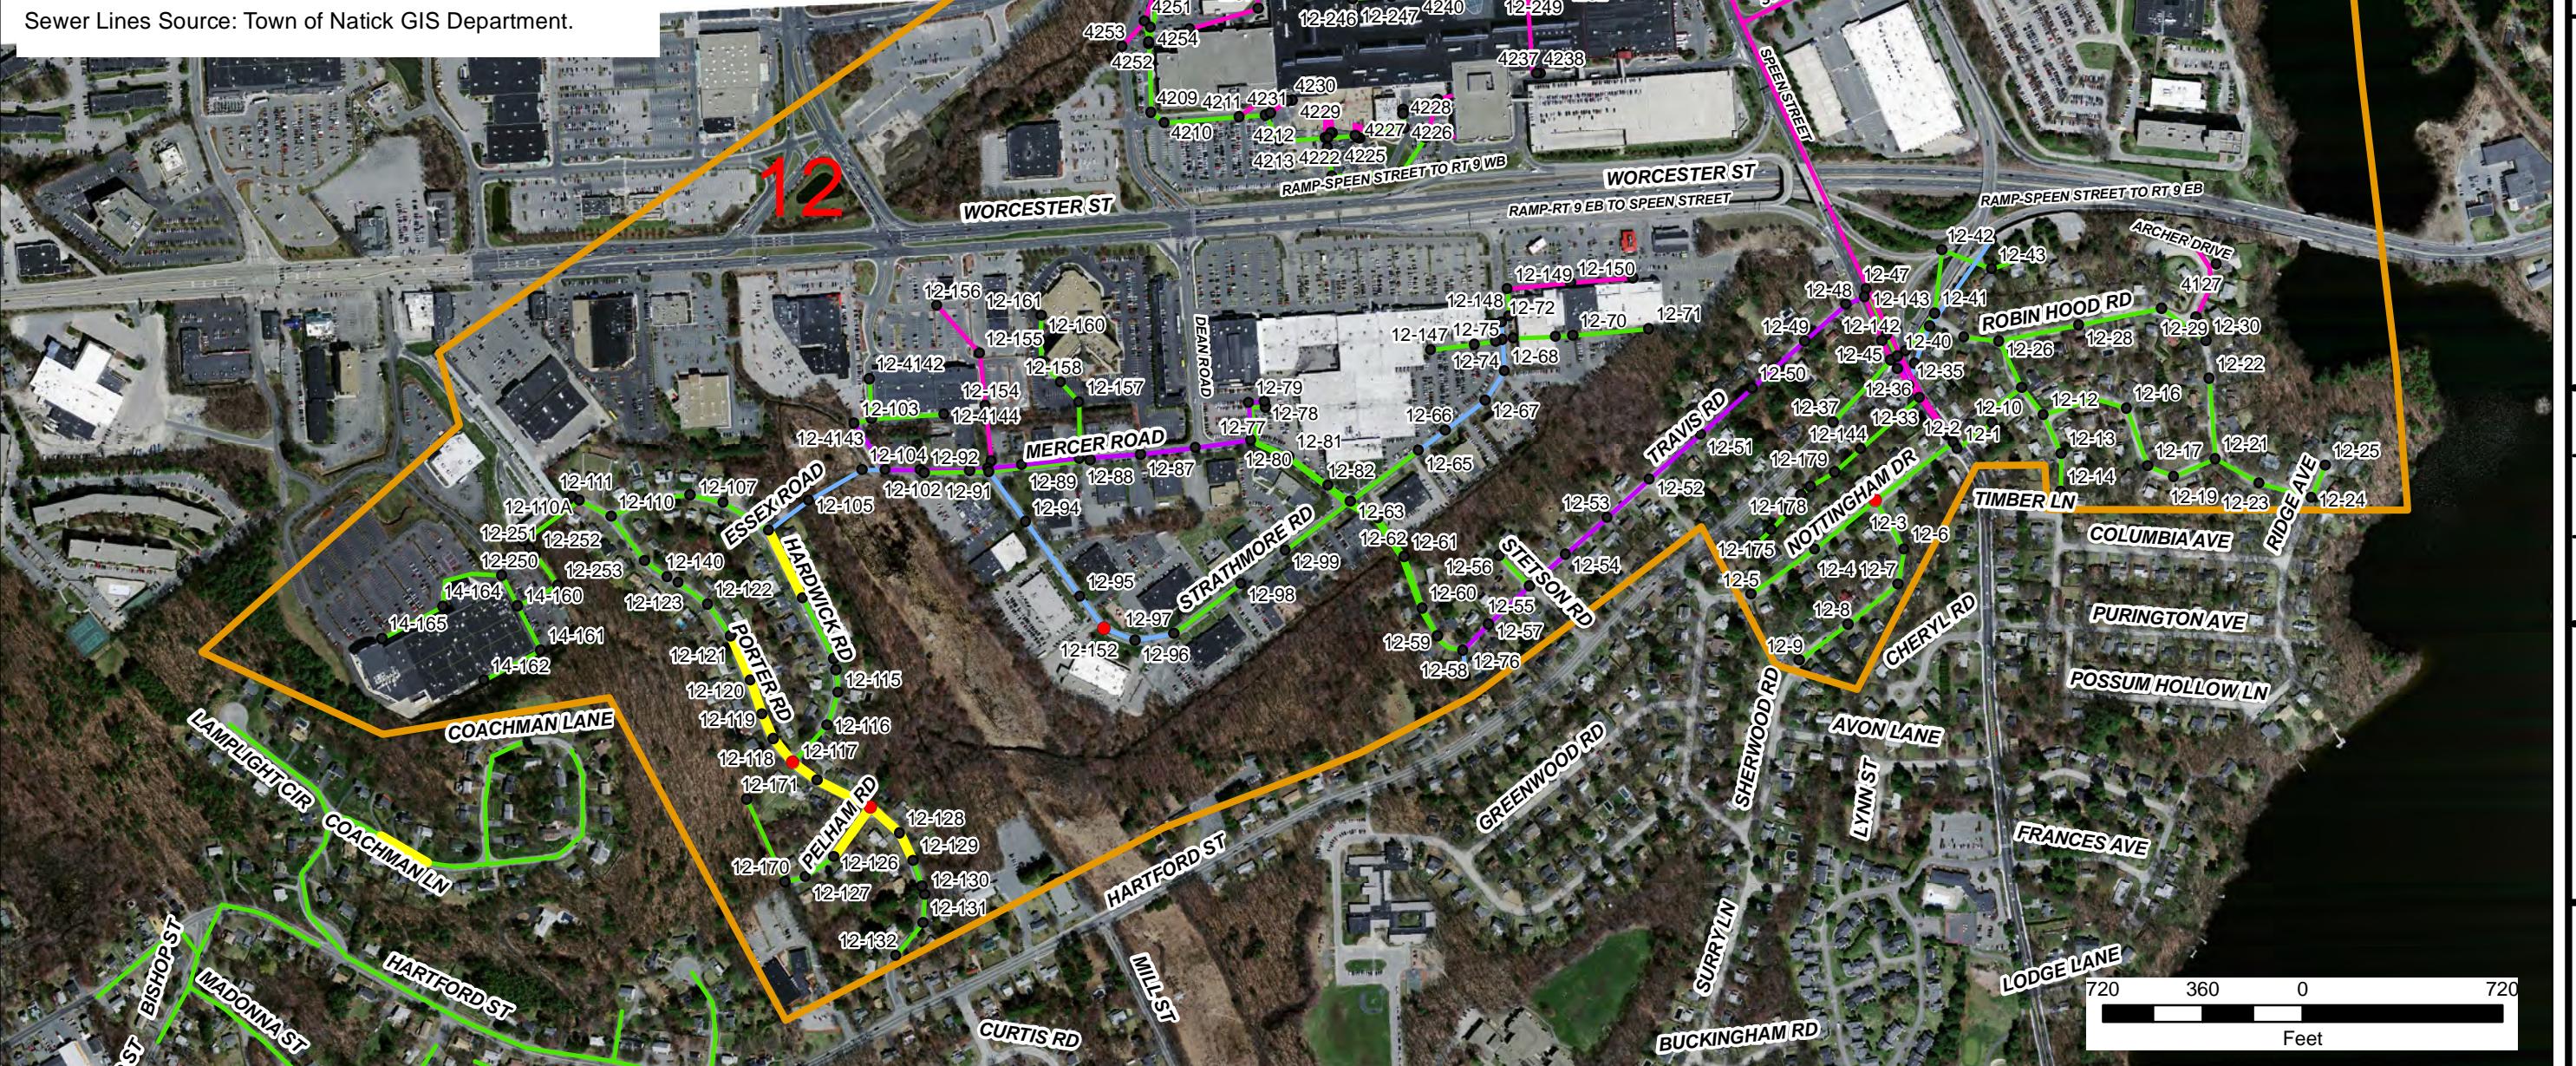

BASIN
12

SHEET NO.:	13 of 20	CHECKED	DATE	BY
CONTRACT NO.:	S-162	REV/SED	DATE	BY
SCALE:	1:5,200			
DATE DRAWN:	JUNE, 2020			
DRAWN BY:	LJC			

FILE NO.: NATT27_BSN_12.MXD

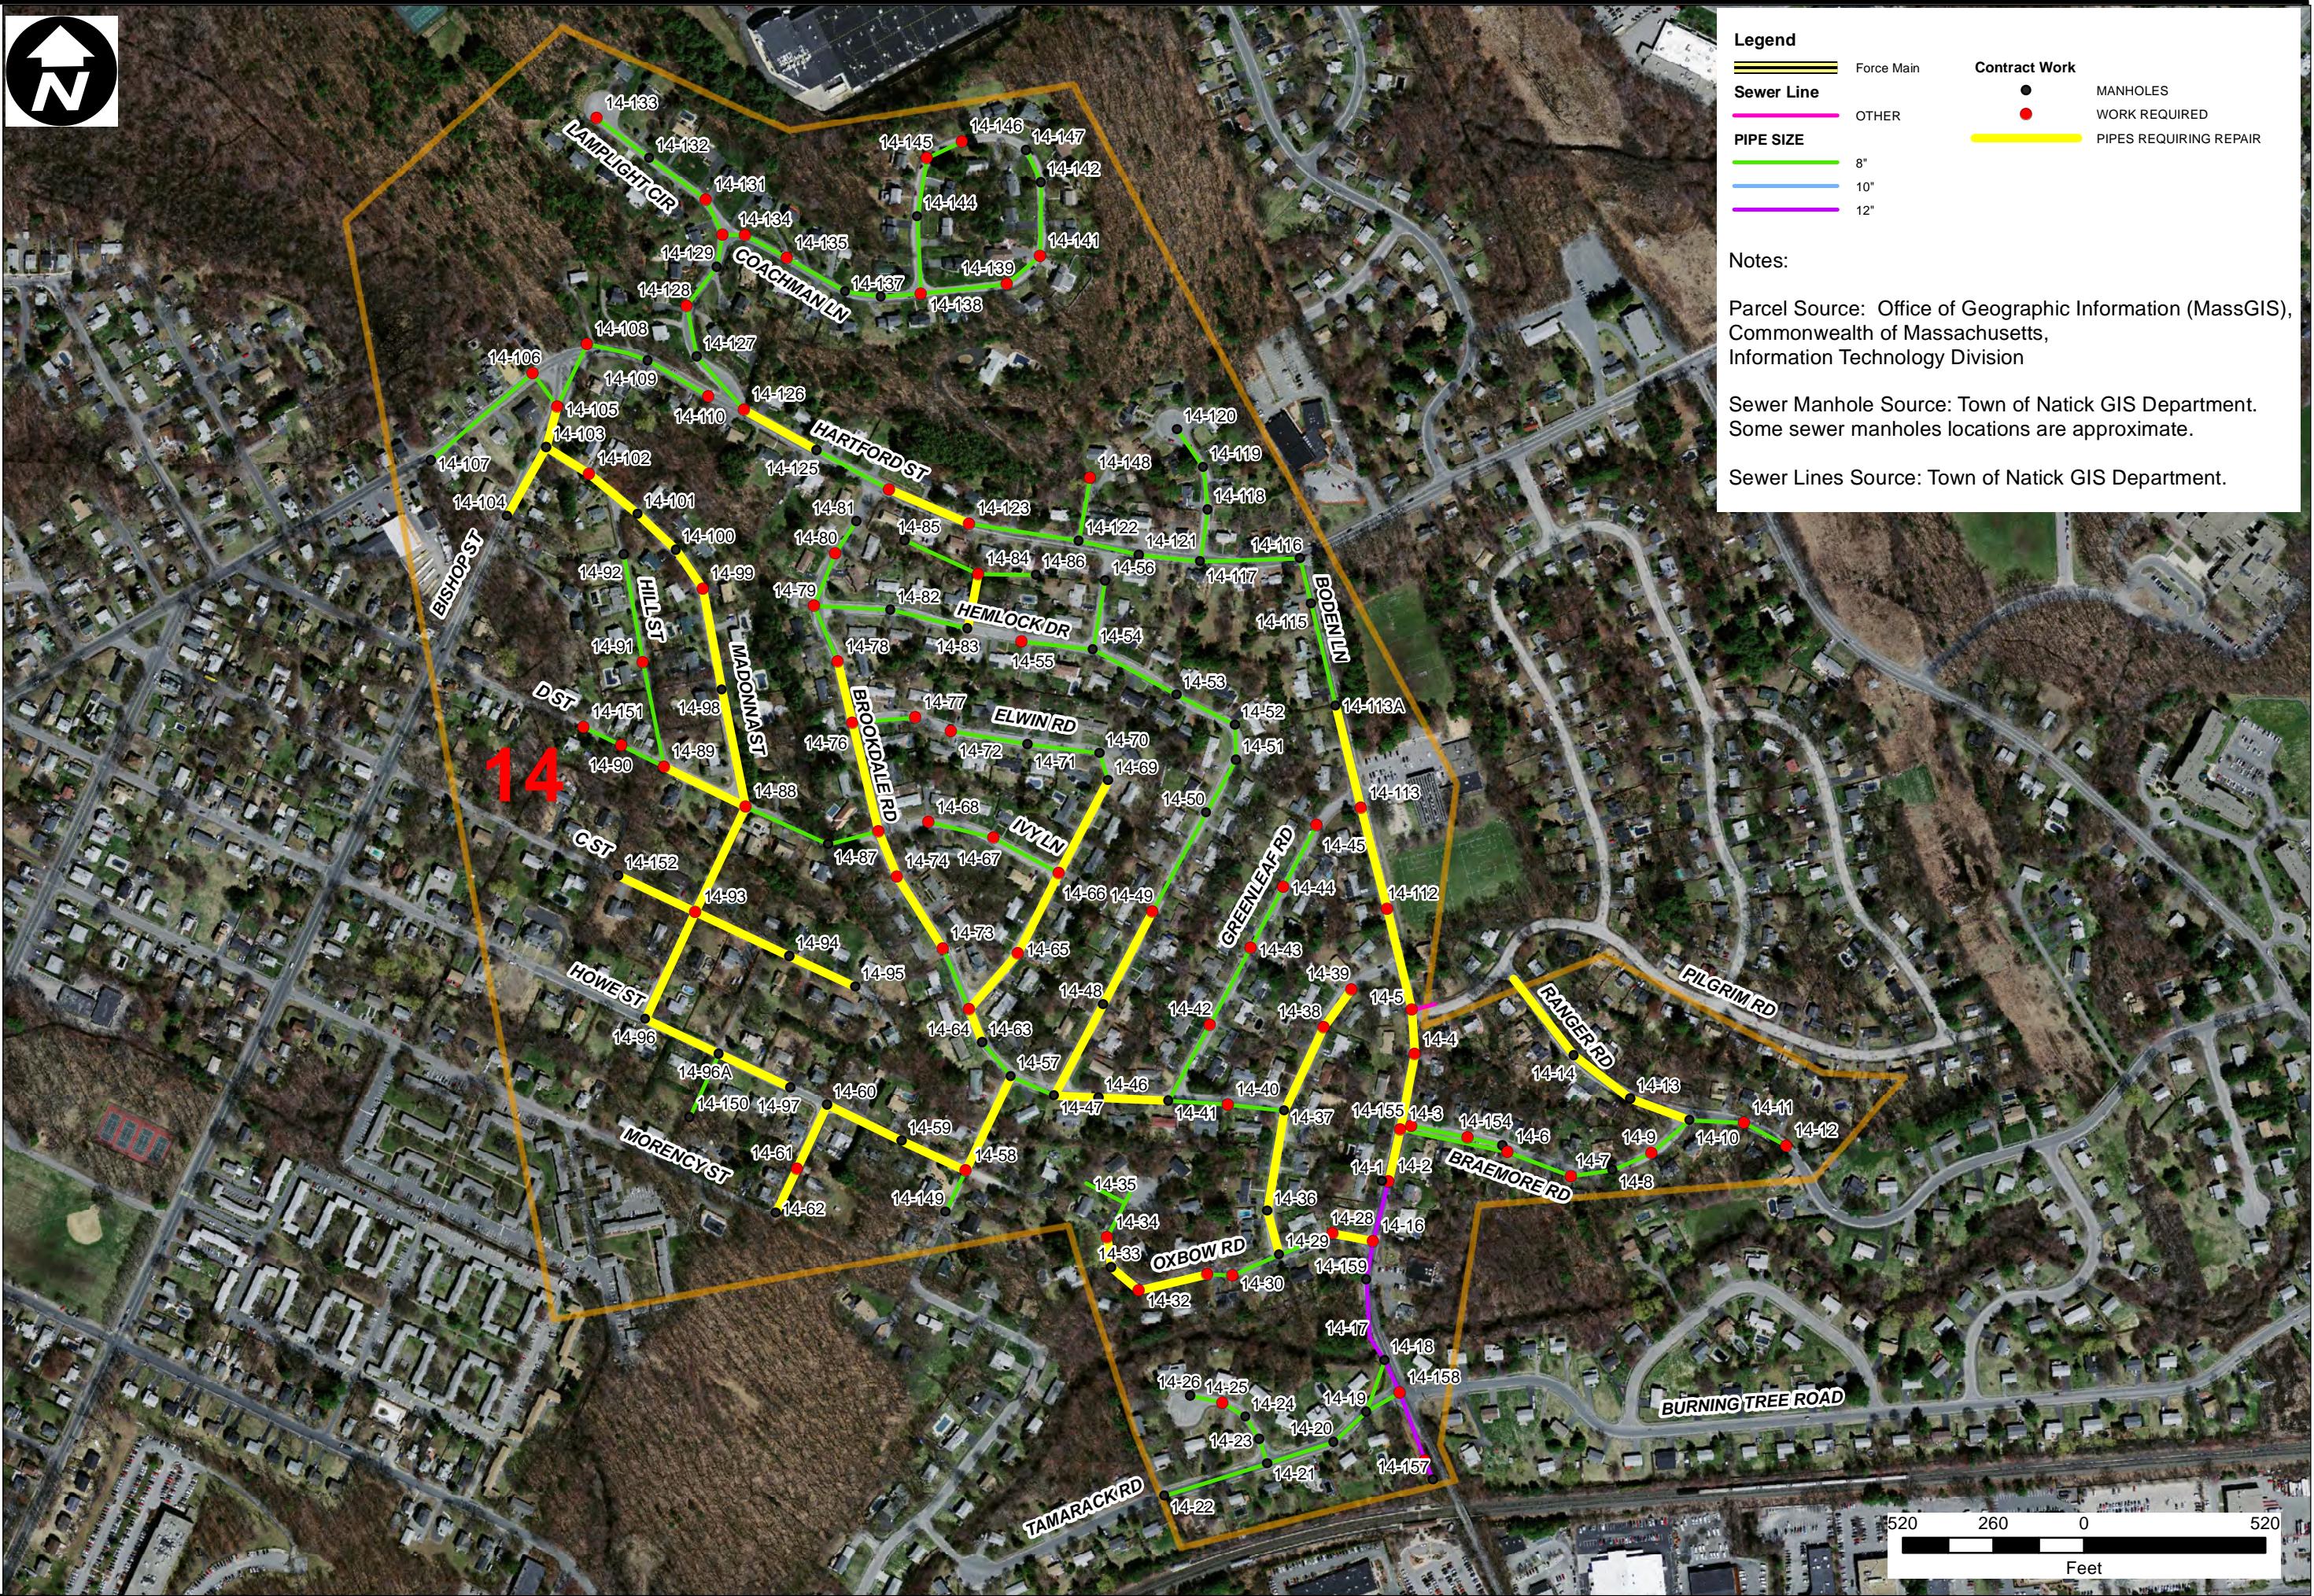

DEPARTMENT OF PUBLIC WORKS
NATICK, MASSACHUSETTS
3 YEAR SEWER REHABILITATION

ADDENDUM NO. 1

Haley and Ward, Inc.
A division of CES Inc.
68 GREAT ROAD, SUITE 200,
MAYNARD, MASSACHUSETTS 01754-2097
PHONE: (978) 848-8025
FAX: (978) 848-8068
www.haleyward.com


BASIN 14

SHEET NO.:	14 of 20	CHECKED	DATE	BY
CONTRACT NO.:	S-162	REVISED	DATE	BY
SCALE:	1:5200			
DATE DRAWN:	JUNE, 2020		<th></th>	
DRAWN BY:	LJC		<th></th>	

FILE NO.: NATT427_BSN_14.MXD



BURNING TREE ROAD

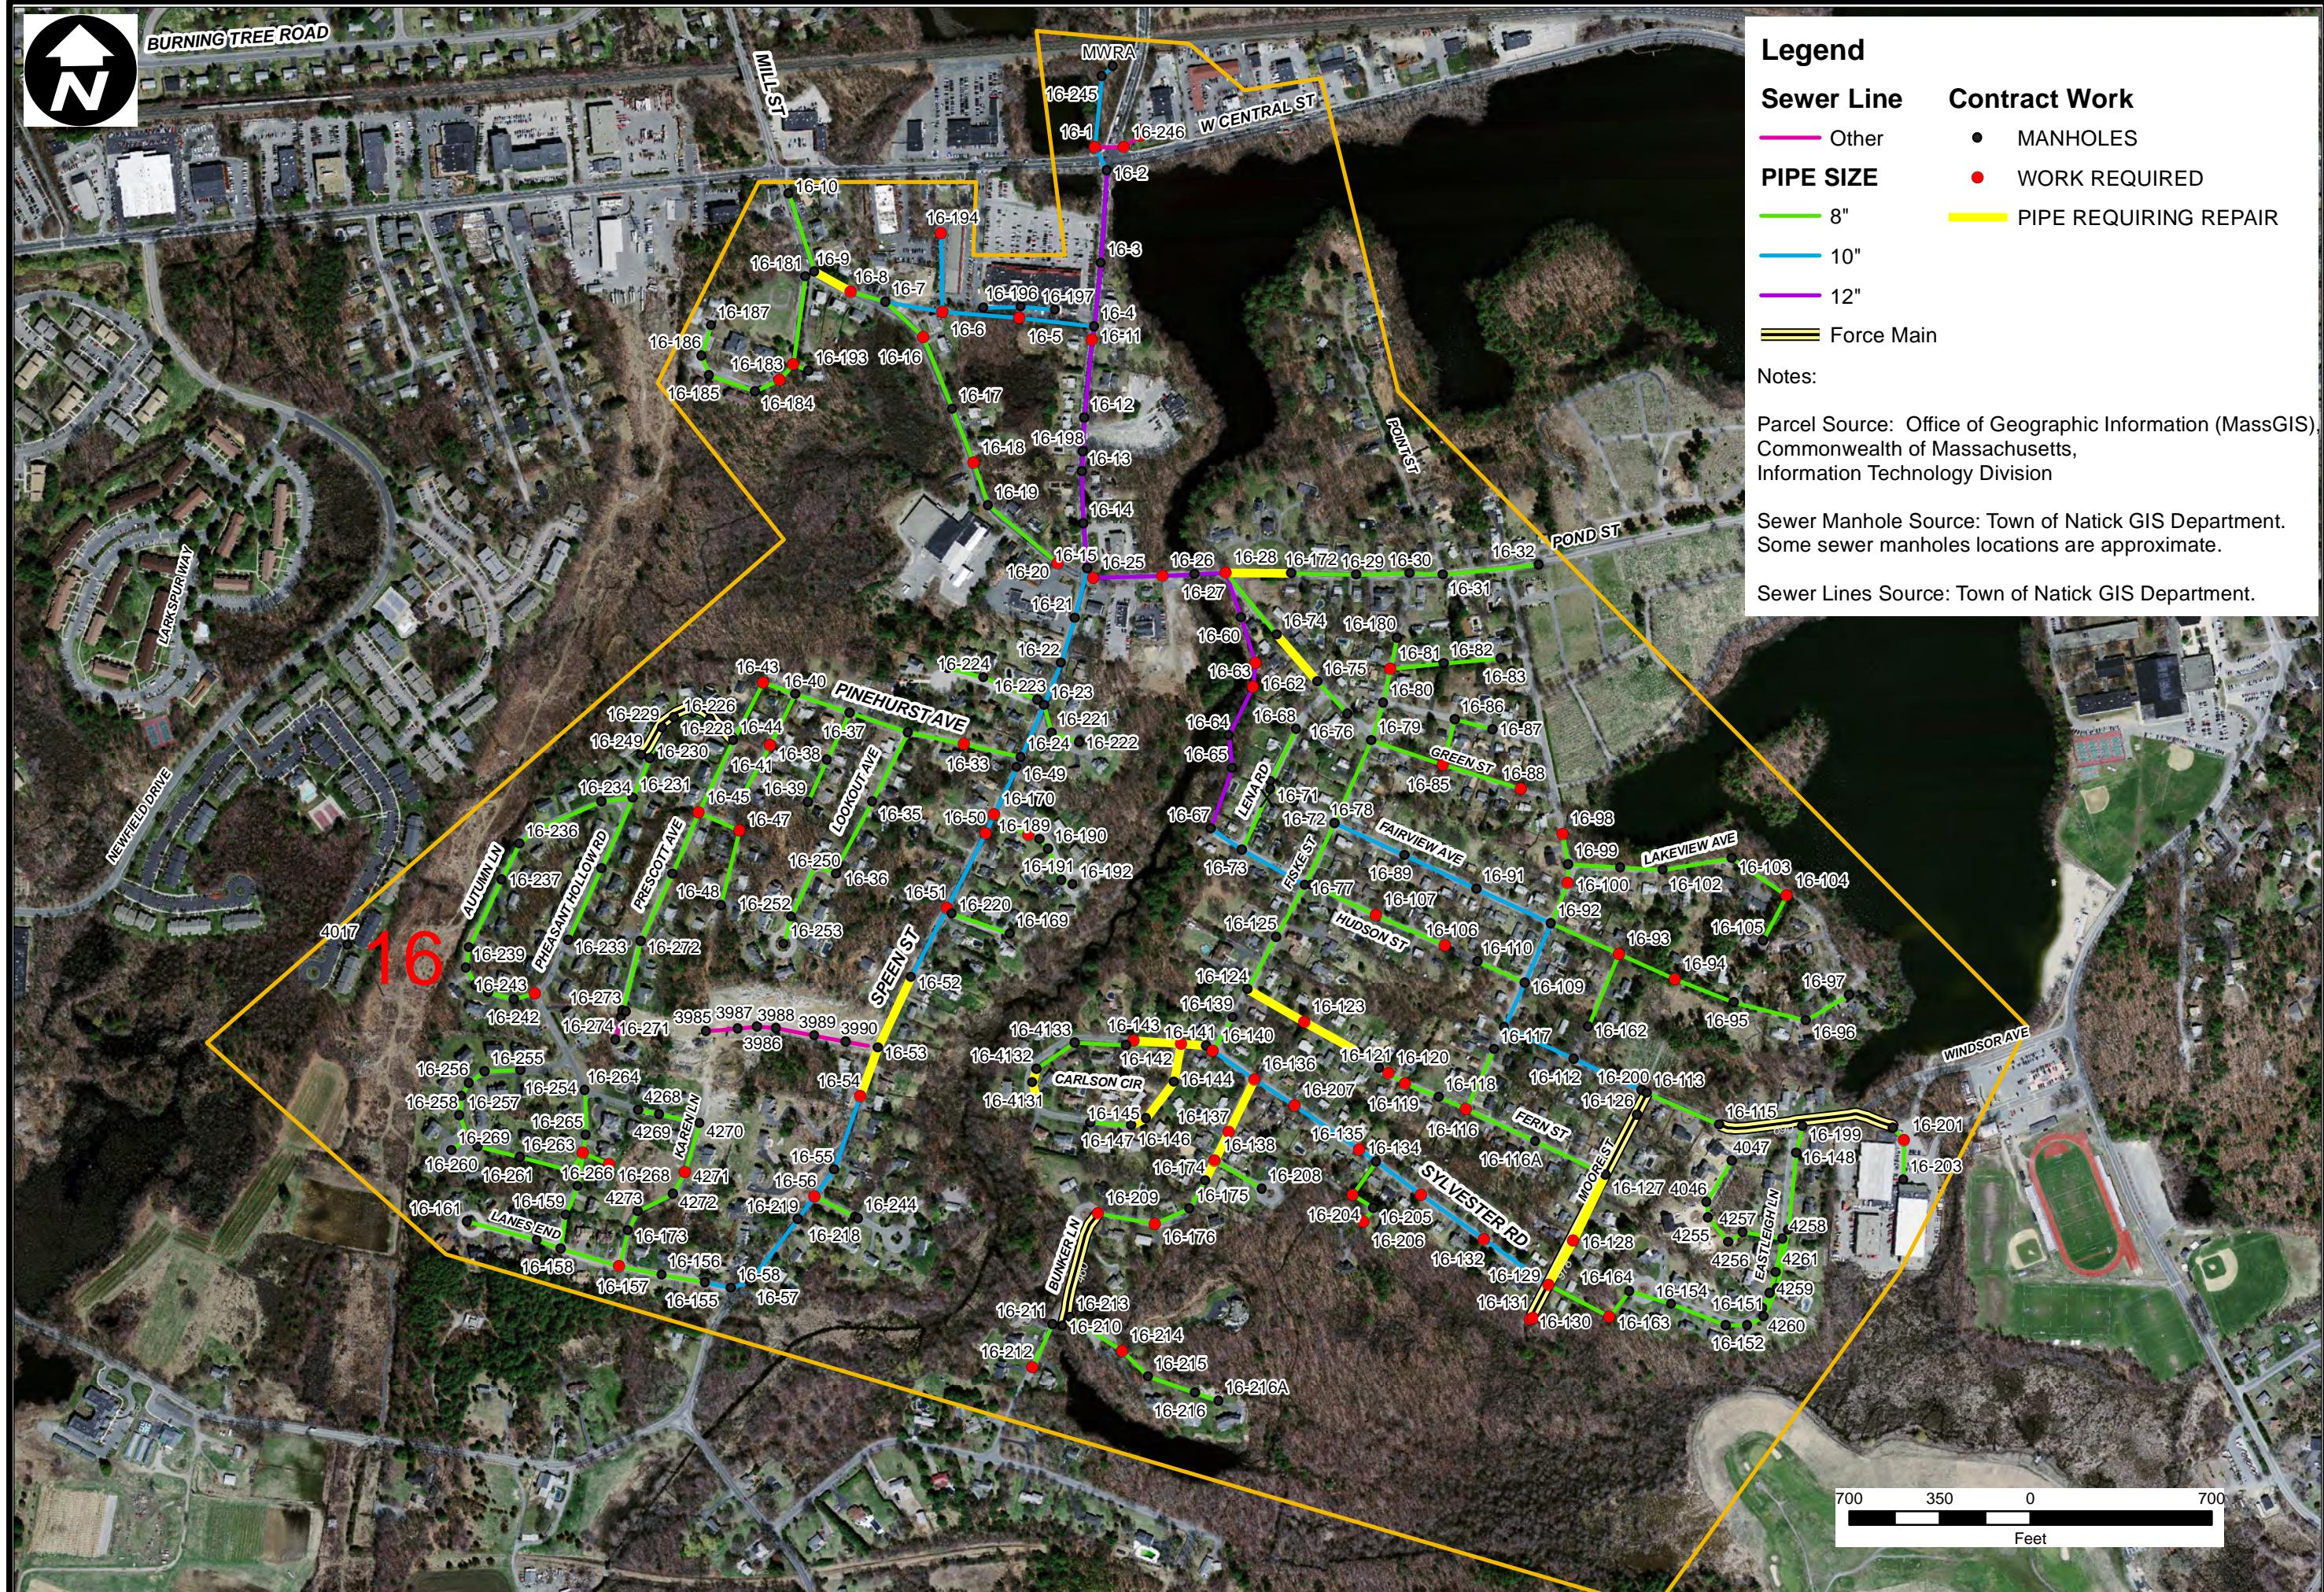

Legend

Sewer Line Contract Work

- MANHOLES
 - WORK REQUIRED
 - PIPES REQUIRING REPAIR

PIPE SIZE

8"

10"

Page 1

Parcel Source: Office of Geographic Information (MassGIS)

Falset Source: Office of Geography
Commonwealth of Massachusetts

Commonwealth of Massachusetts Information Technology Division

Sewer Manhole Source: Town of Natick GIS Department.

Some sewer manholes locations are approximate.

Sewer Lines Source: Town of Natick GIS Department.



3 YEAR SEWER DEPARTMENT OF PUBLIC WORKS NATICK, MASSACHUSETTS

**DDENDUM
NO. 1**

Haley and Ward, Inc.
A division of CES Inc.
63 GREAT ROAD, SUITE 200,
MAYNARD, MASSACHUSETTS 01754-2097
PHONE: (978) 848-6025
FAX: (978) 848-6068

DATE DRAWN: 11/16/2020
SHEET NO.: 10 of 20
CONTRACT NO.: S-162
SCALE: 1:4,200

BASIN 17



DEPARTMENT OF PUBLIC WORKS
NATICK, MASSACHUSETTS3 YEAR SEWER
REHABILITATIONADDENDUM
NO. 1

Haley and Ward, Inc.
A division of CES Inc.
63 GREAT ROAD, SUITE 200,
MAYNARD, MASSACHUSETTS 01754-2097
PHONE: (978) 648-8025
FAX: (978) 648-8068
www.haleyward.com

Legend

Sewer Line Contract Work


- Other
- MANHOLES
- PIPE SIZE — 8"
- 10"
- 12"
- Force Main
- WORK REQUIRED
- PIPES REQUIRING REPAIR

Notes:

Parcel Source: Office of Geographic Information (MassGIS)
Commonwealth of Massachusetts,
Information Technology Division

Sewer Manhole Source: Town of Natick GIS Department.
Some sewer manholes locations are approximate.


Sewer Lines Source: Town of Natick GIS Department.

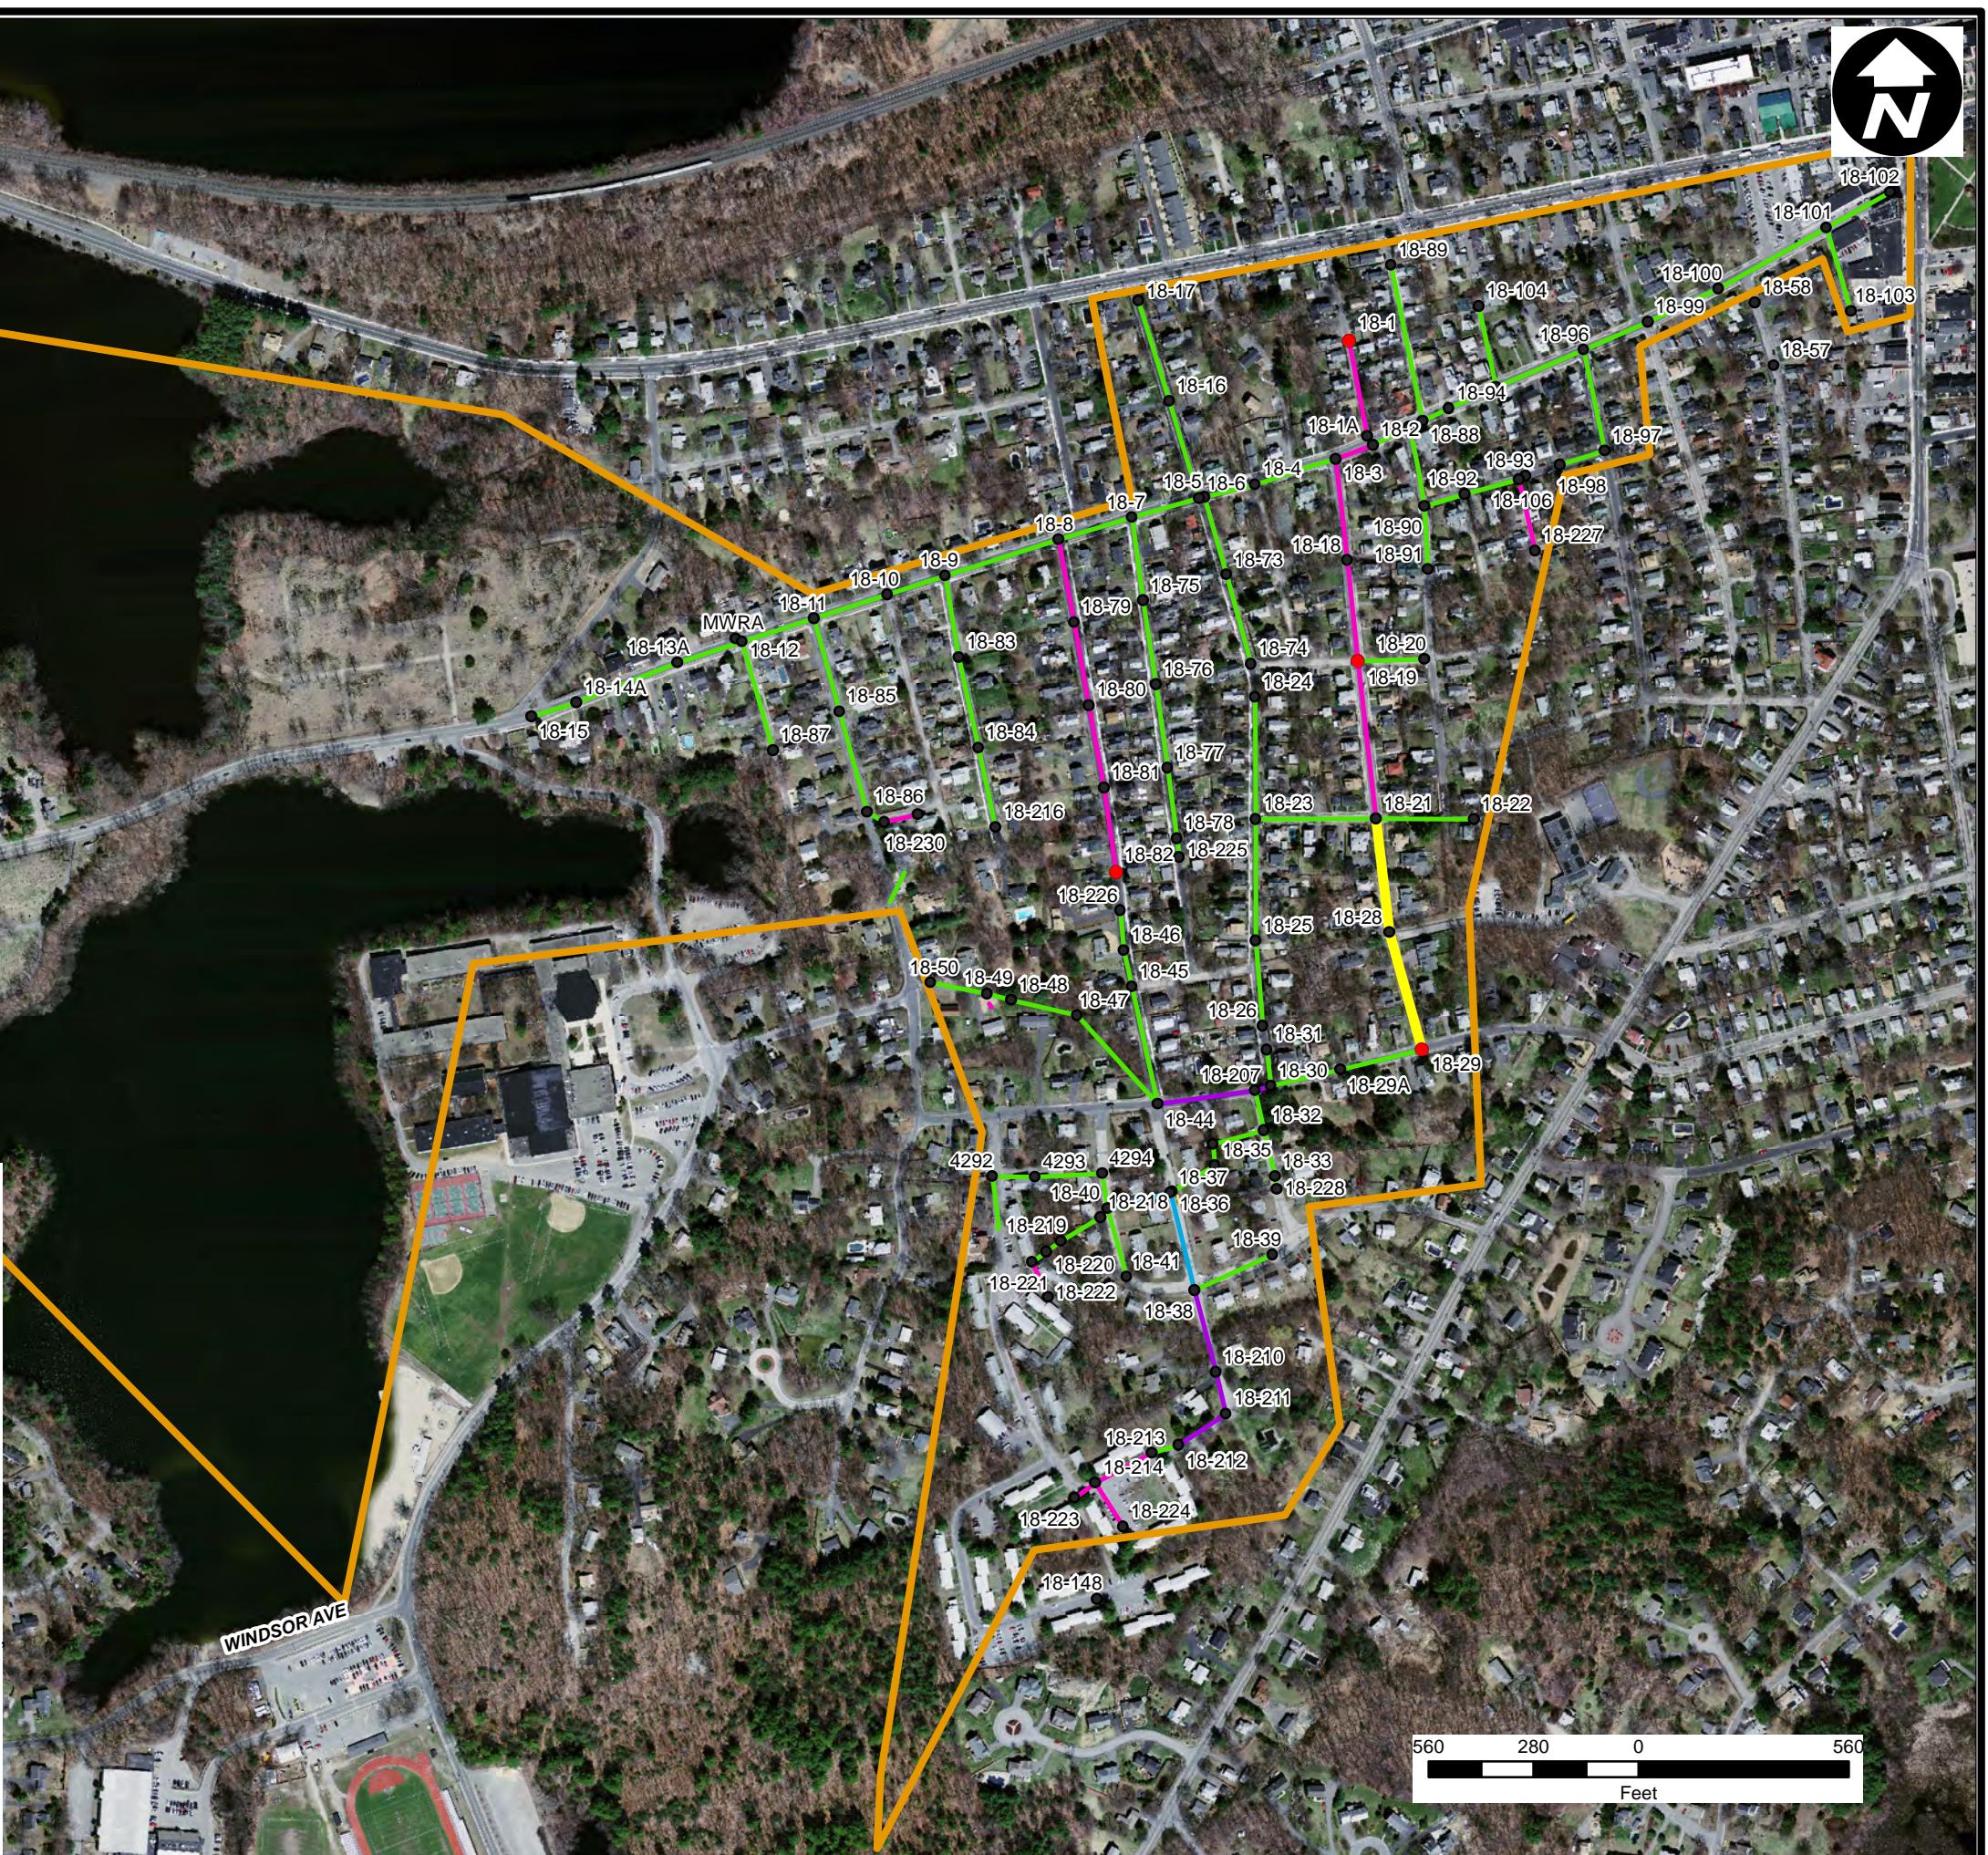

560 280 0 560
Feet

BASIN
18

SHEET NO.:	17 of 20	CHECKED	DATE	BY
CONTRACT NO.:	S-162	REVISED	DATE	BY
SCALE:	1:5,600			
DATE DRAWN:	JUNE, 2020			
DRAWN BY:	LJC			
FILE NO.:	NATK27_BSN_18.MXD			

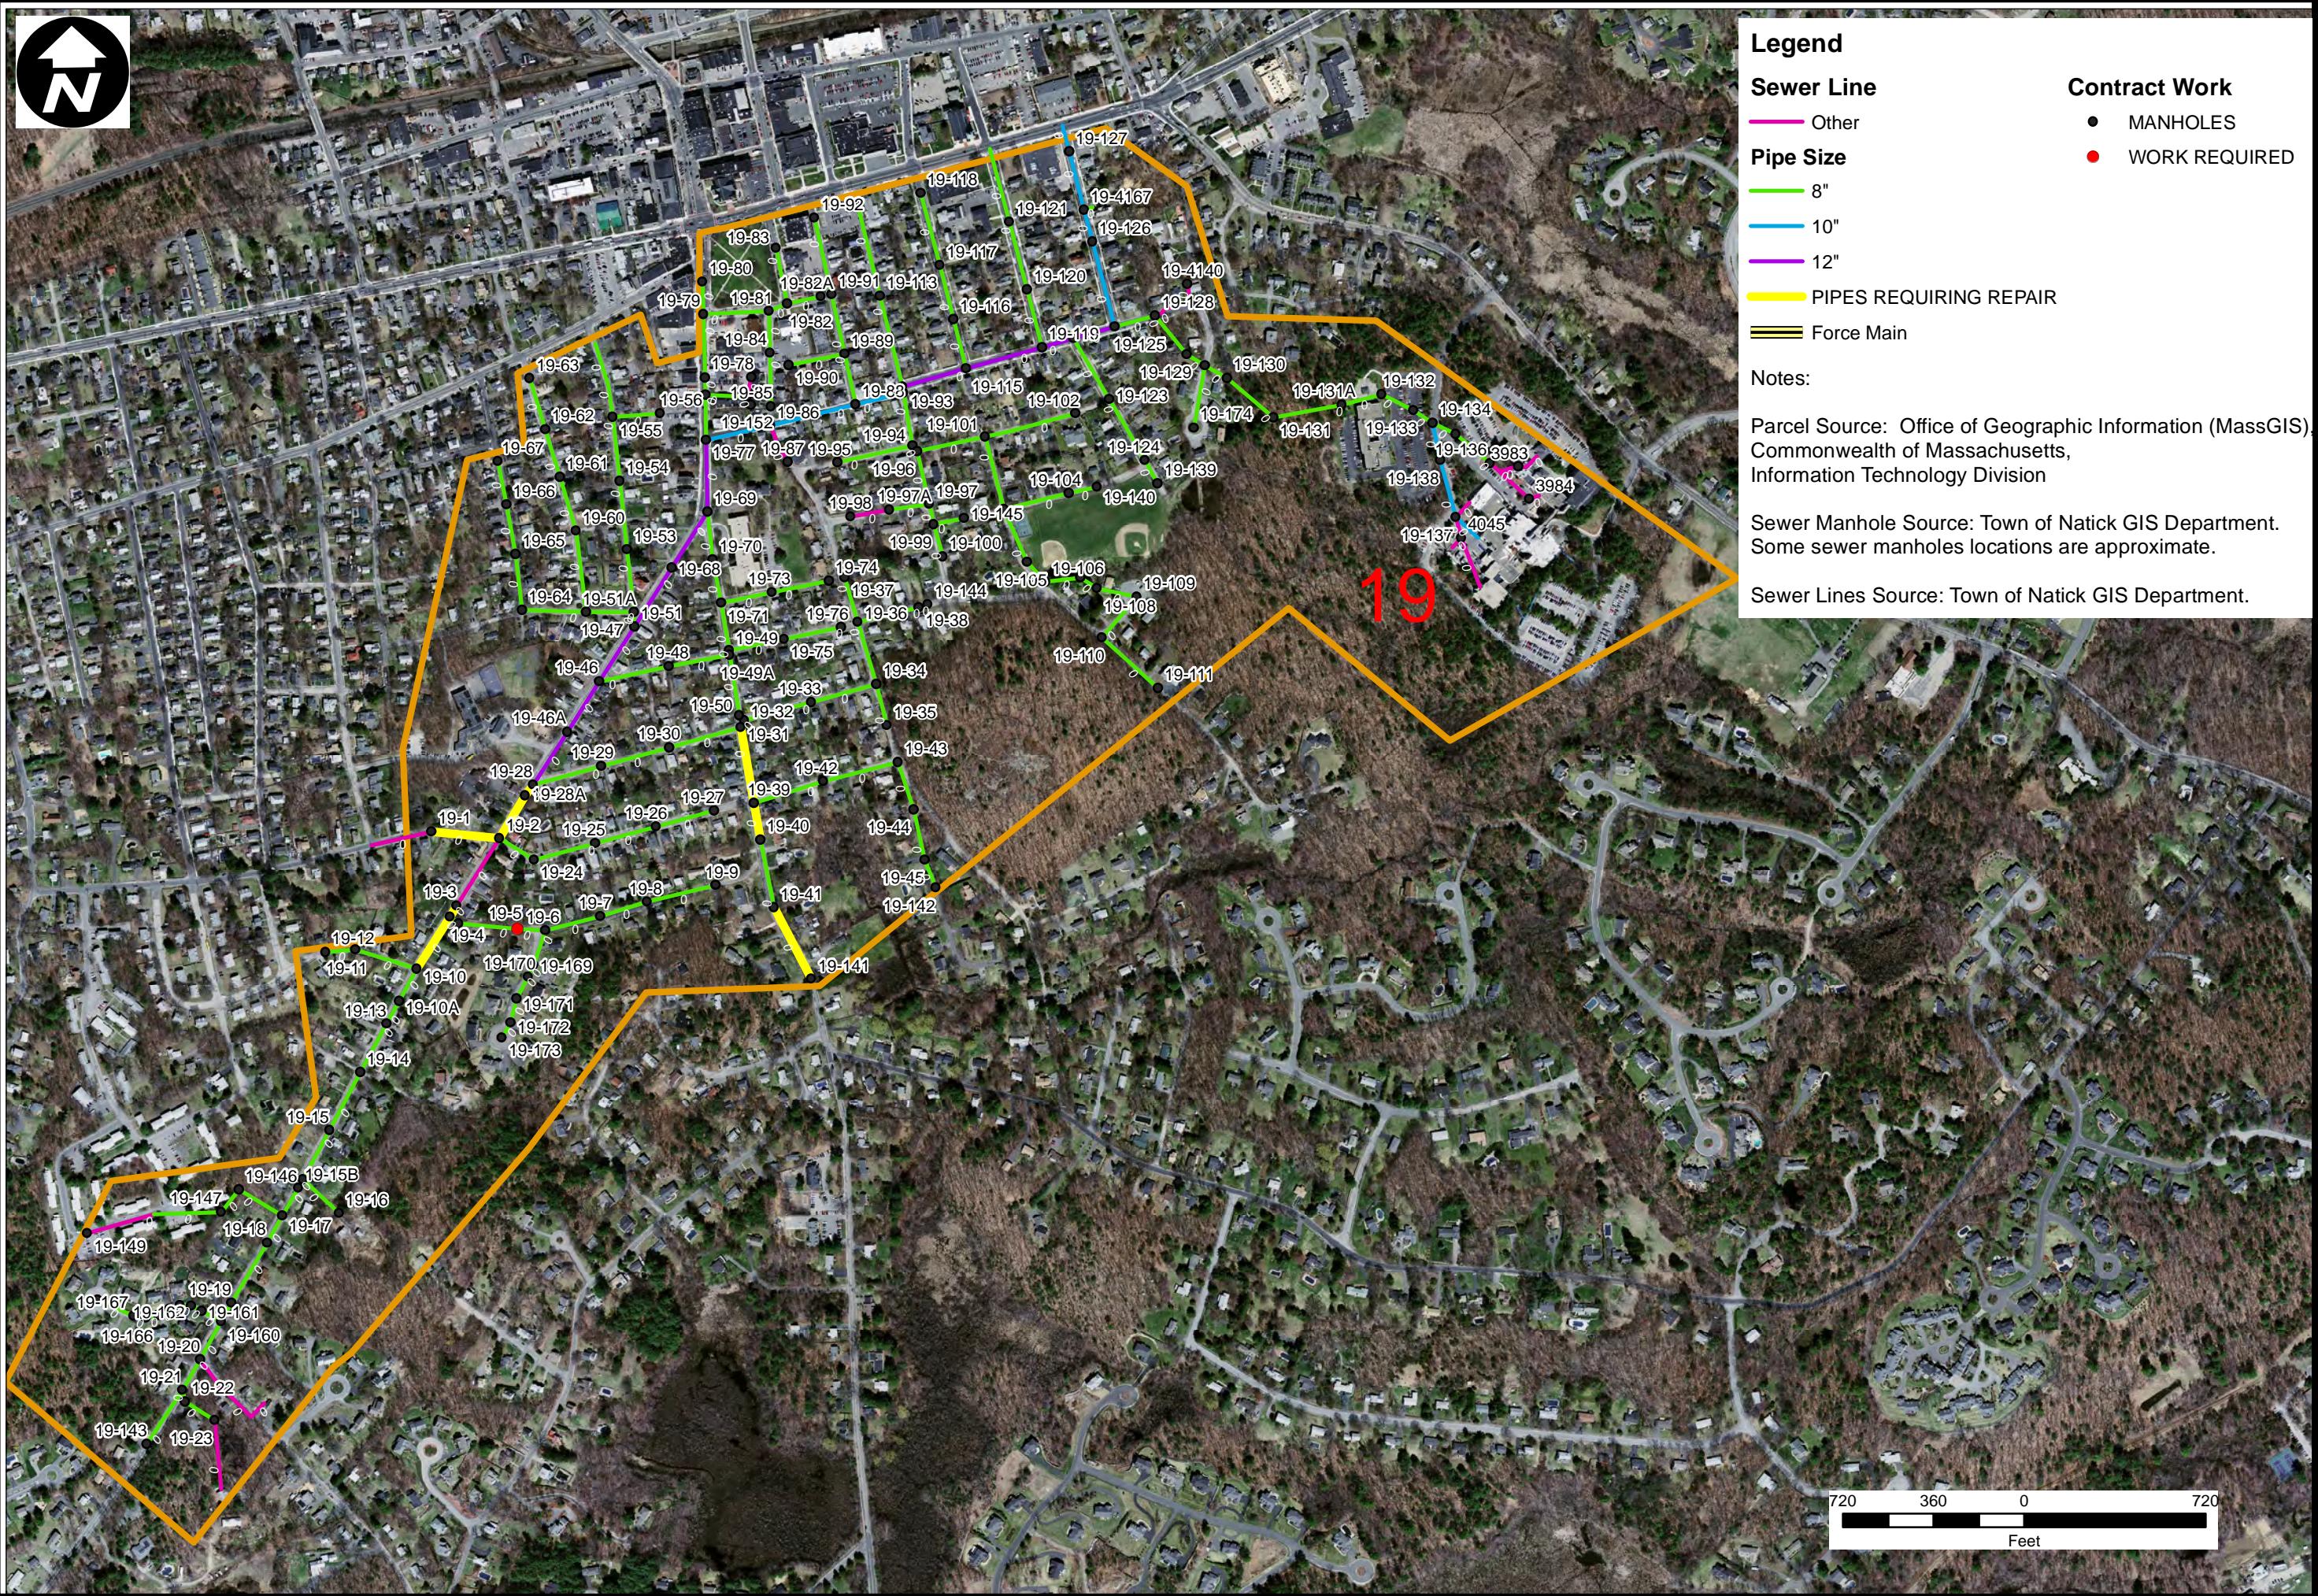

DEPARTMENT OF PUBLIC WORKS
NATICK, MASSACHUSETTS
**3 YEAR SEWER
REHABILITATION**

**ADDENDUM
NO. 1**

SHEET NO.: 18 of 20
CONTRACT NO.: S-162
SCALE: 1:7200
DATE DRAWN: JUNE, 2020
DRAWN BY: LJC
FILE NO.: NATT427_BSN_19.MXD



DEPARTMENT OF PUBLIC WORKS
NATICK, MASSACHUSETTS
3 YEAR SEWER REHABILITATION

**ADDENDUM
NO. 1**

Haley and Ward, Inc.
A division of CES Inc.
68 GREAT ROAD, SUITE 200,
MAYNARD, MASSACHUSETTS 01754-2097
PHONE: (978) 848-8025
FAX: (978) 848-8068
www.haleyward.com

Legend

Sewer Line Contract Work

- MANHOLES
- WORK REQUIRED

PIPE SIZE


- 8"
- 10"
- 12"

Notes:

Parcel Source: Office of Geographic Information (MassGIS)
Commonwealth of Massachusetts,
Information Technology Division

Sewer Manhole Source: Town of Natick GIS Department.
Some sewer manholes locations are approximate.

Sewer Lines Source: Town of Natick GIS Department.

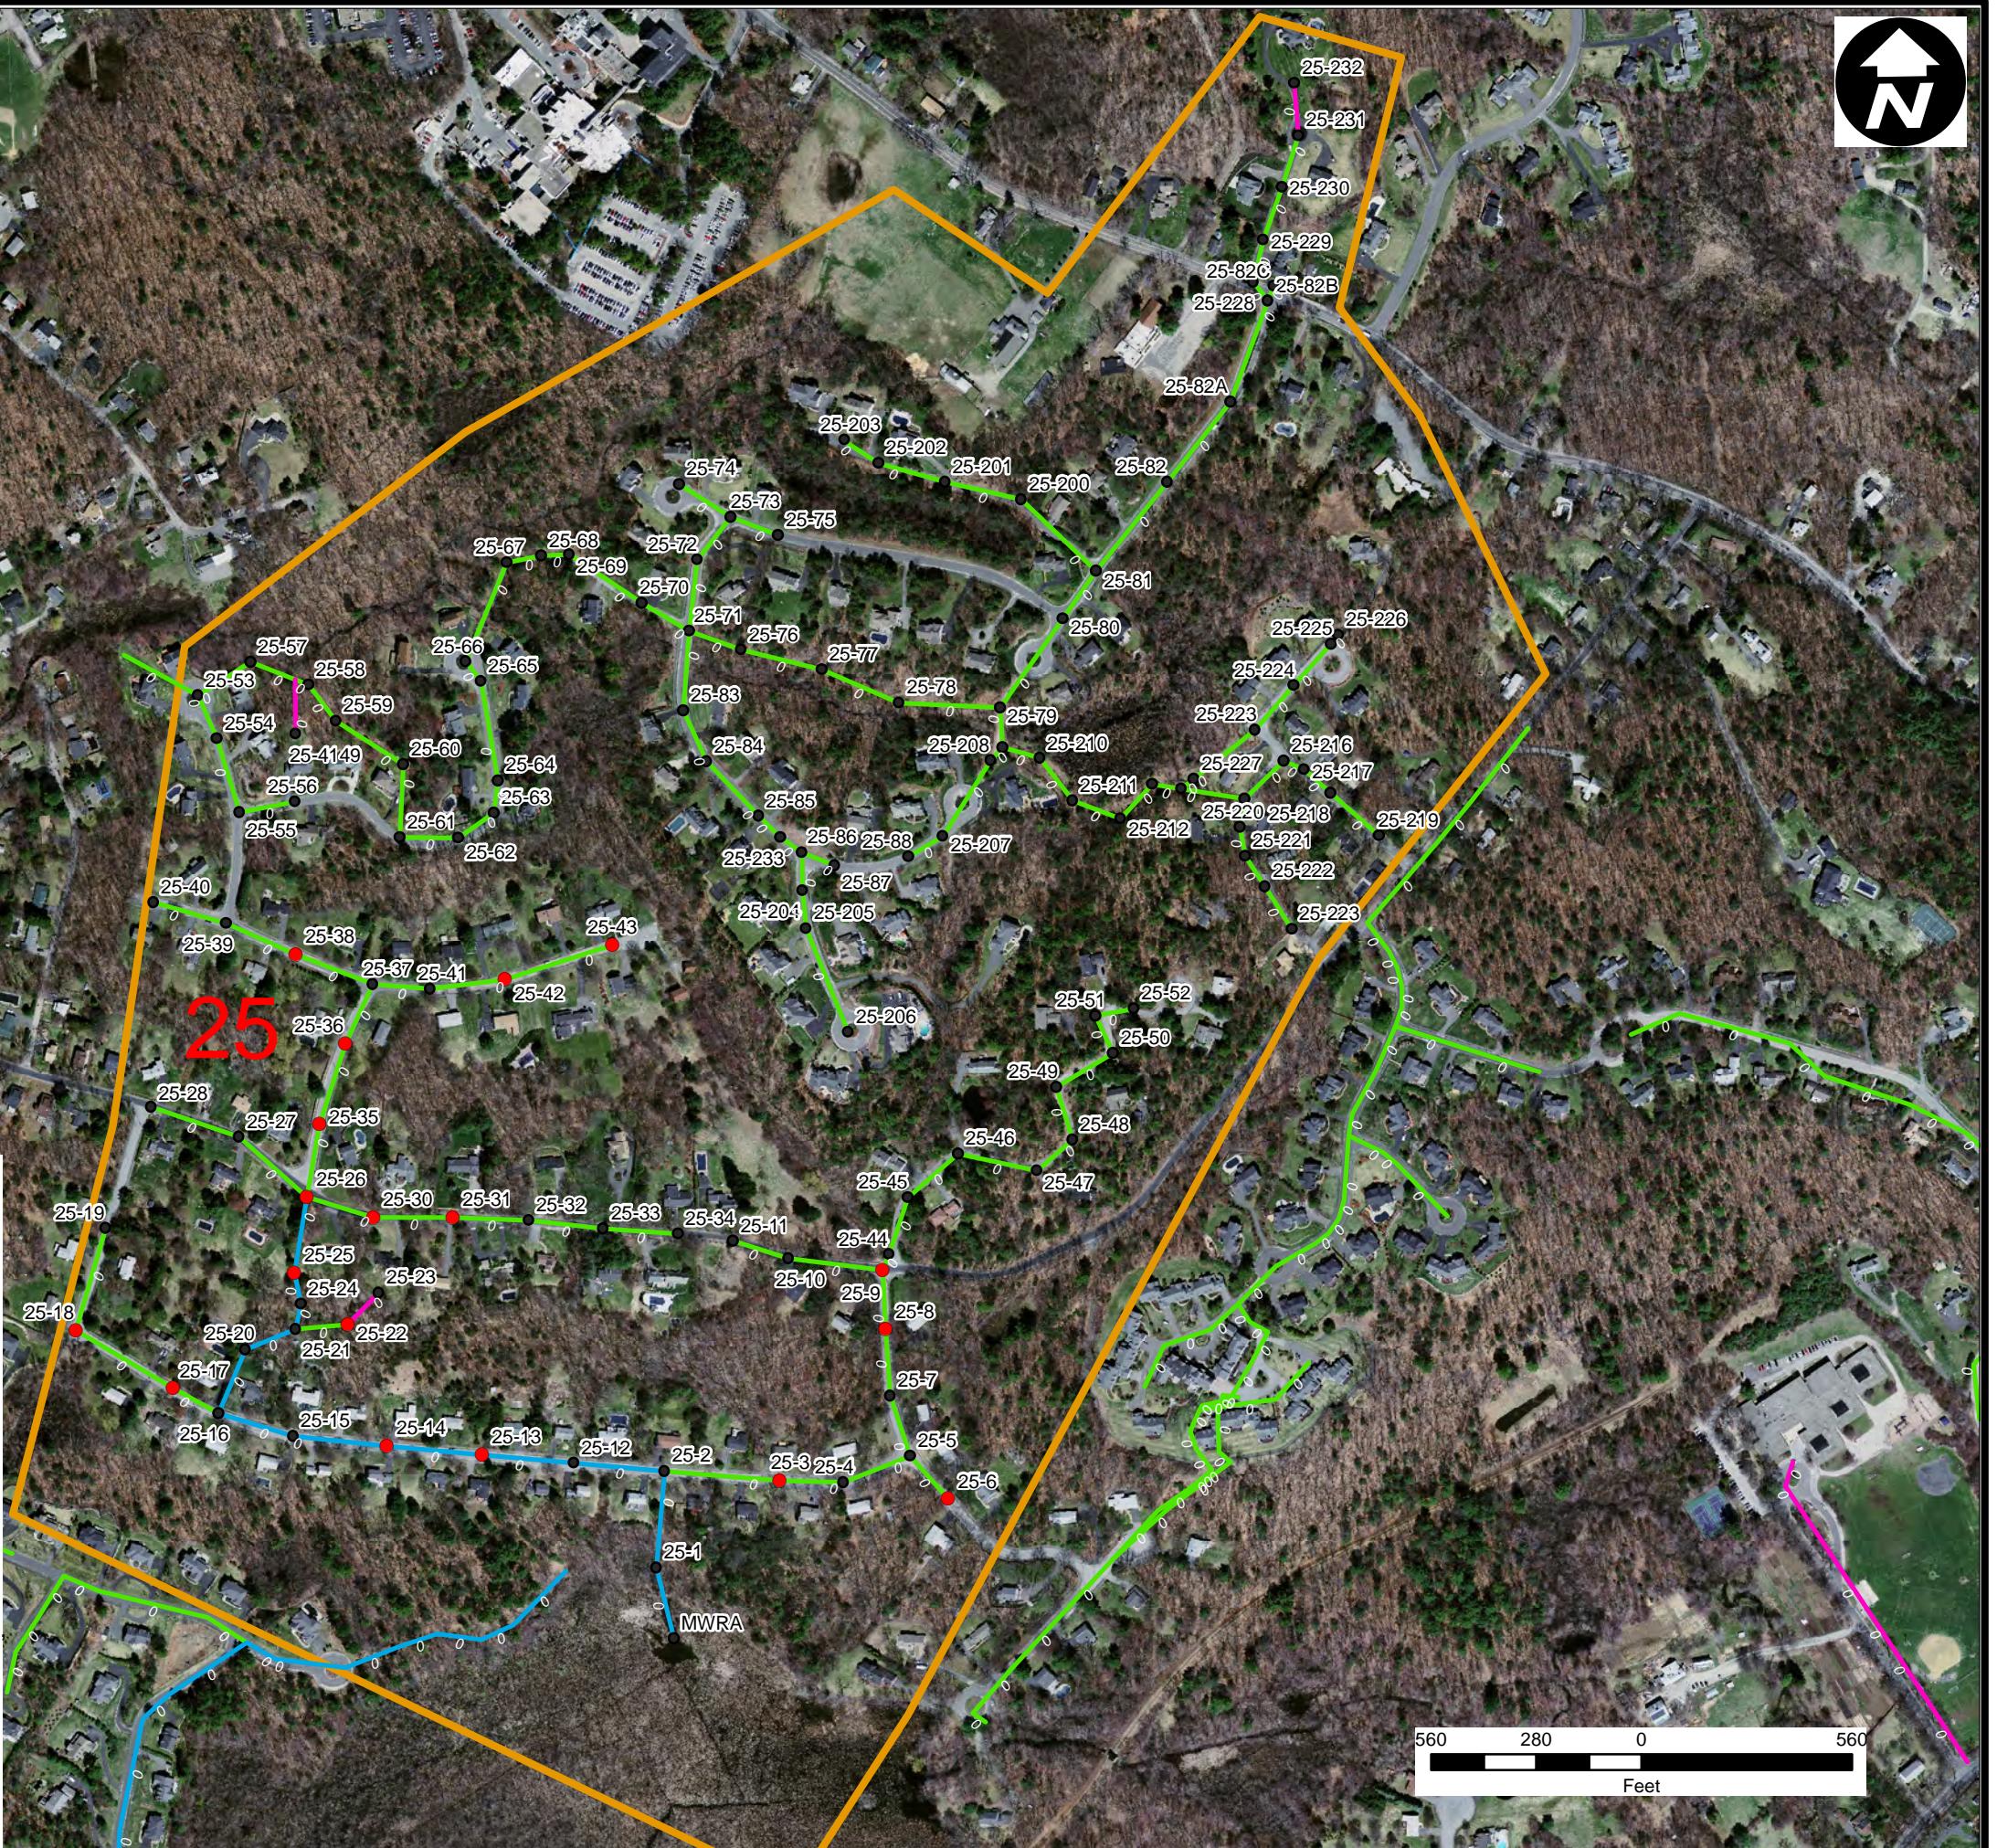

**BASIN
25**

SHEET NO.:	19 of 20
CONTRACT NO.:	S-162
SCALE:	1:5,600
DATE DRAWN:	JUNE 2020
DRAWN BY:	LJC

FILE NO.: NATT27_BSN_25.MXD



DEPARTMENT OF PUBLIC WORKS
NATICK, MASSACHUSETTS
**3 YEAR SEWER
REHABILITATION**

**ADDENDUM
NO. 1**

Haley and Ward, Inc.
A division of CES Inc.
68 GREAT ROAD, SUITE 200,
MAYNARD, MASSACHUSETTS 01754-2097
PHONE: (978) 848-8025
FAX: (978) 848-8068
www.haleyward.com

Legend

Sewer Line Contract Work


- | | |
|---|--------------------------|
| — Other | ● MANHOLES |
| PIPE SIZE | ● WORK REQUIRED |
| — 8" | — PIPES REQUIRING REPAIR |
| — 10" | |
| — 12" | |
| — Force Main | |

Notes:

Parcel Source: Office of Geographic Information (MassGIS)
Commonwealth of Massachusetts,
Information Technology Division


Sewer Manhole Source: Town of Natick GIS Department.
Some sewer manhole locations are approximate.

Sewer Lines Source: Town of Natick GIS Department.

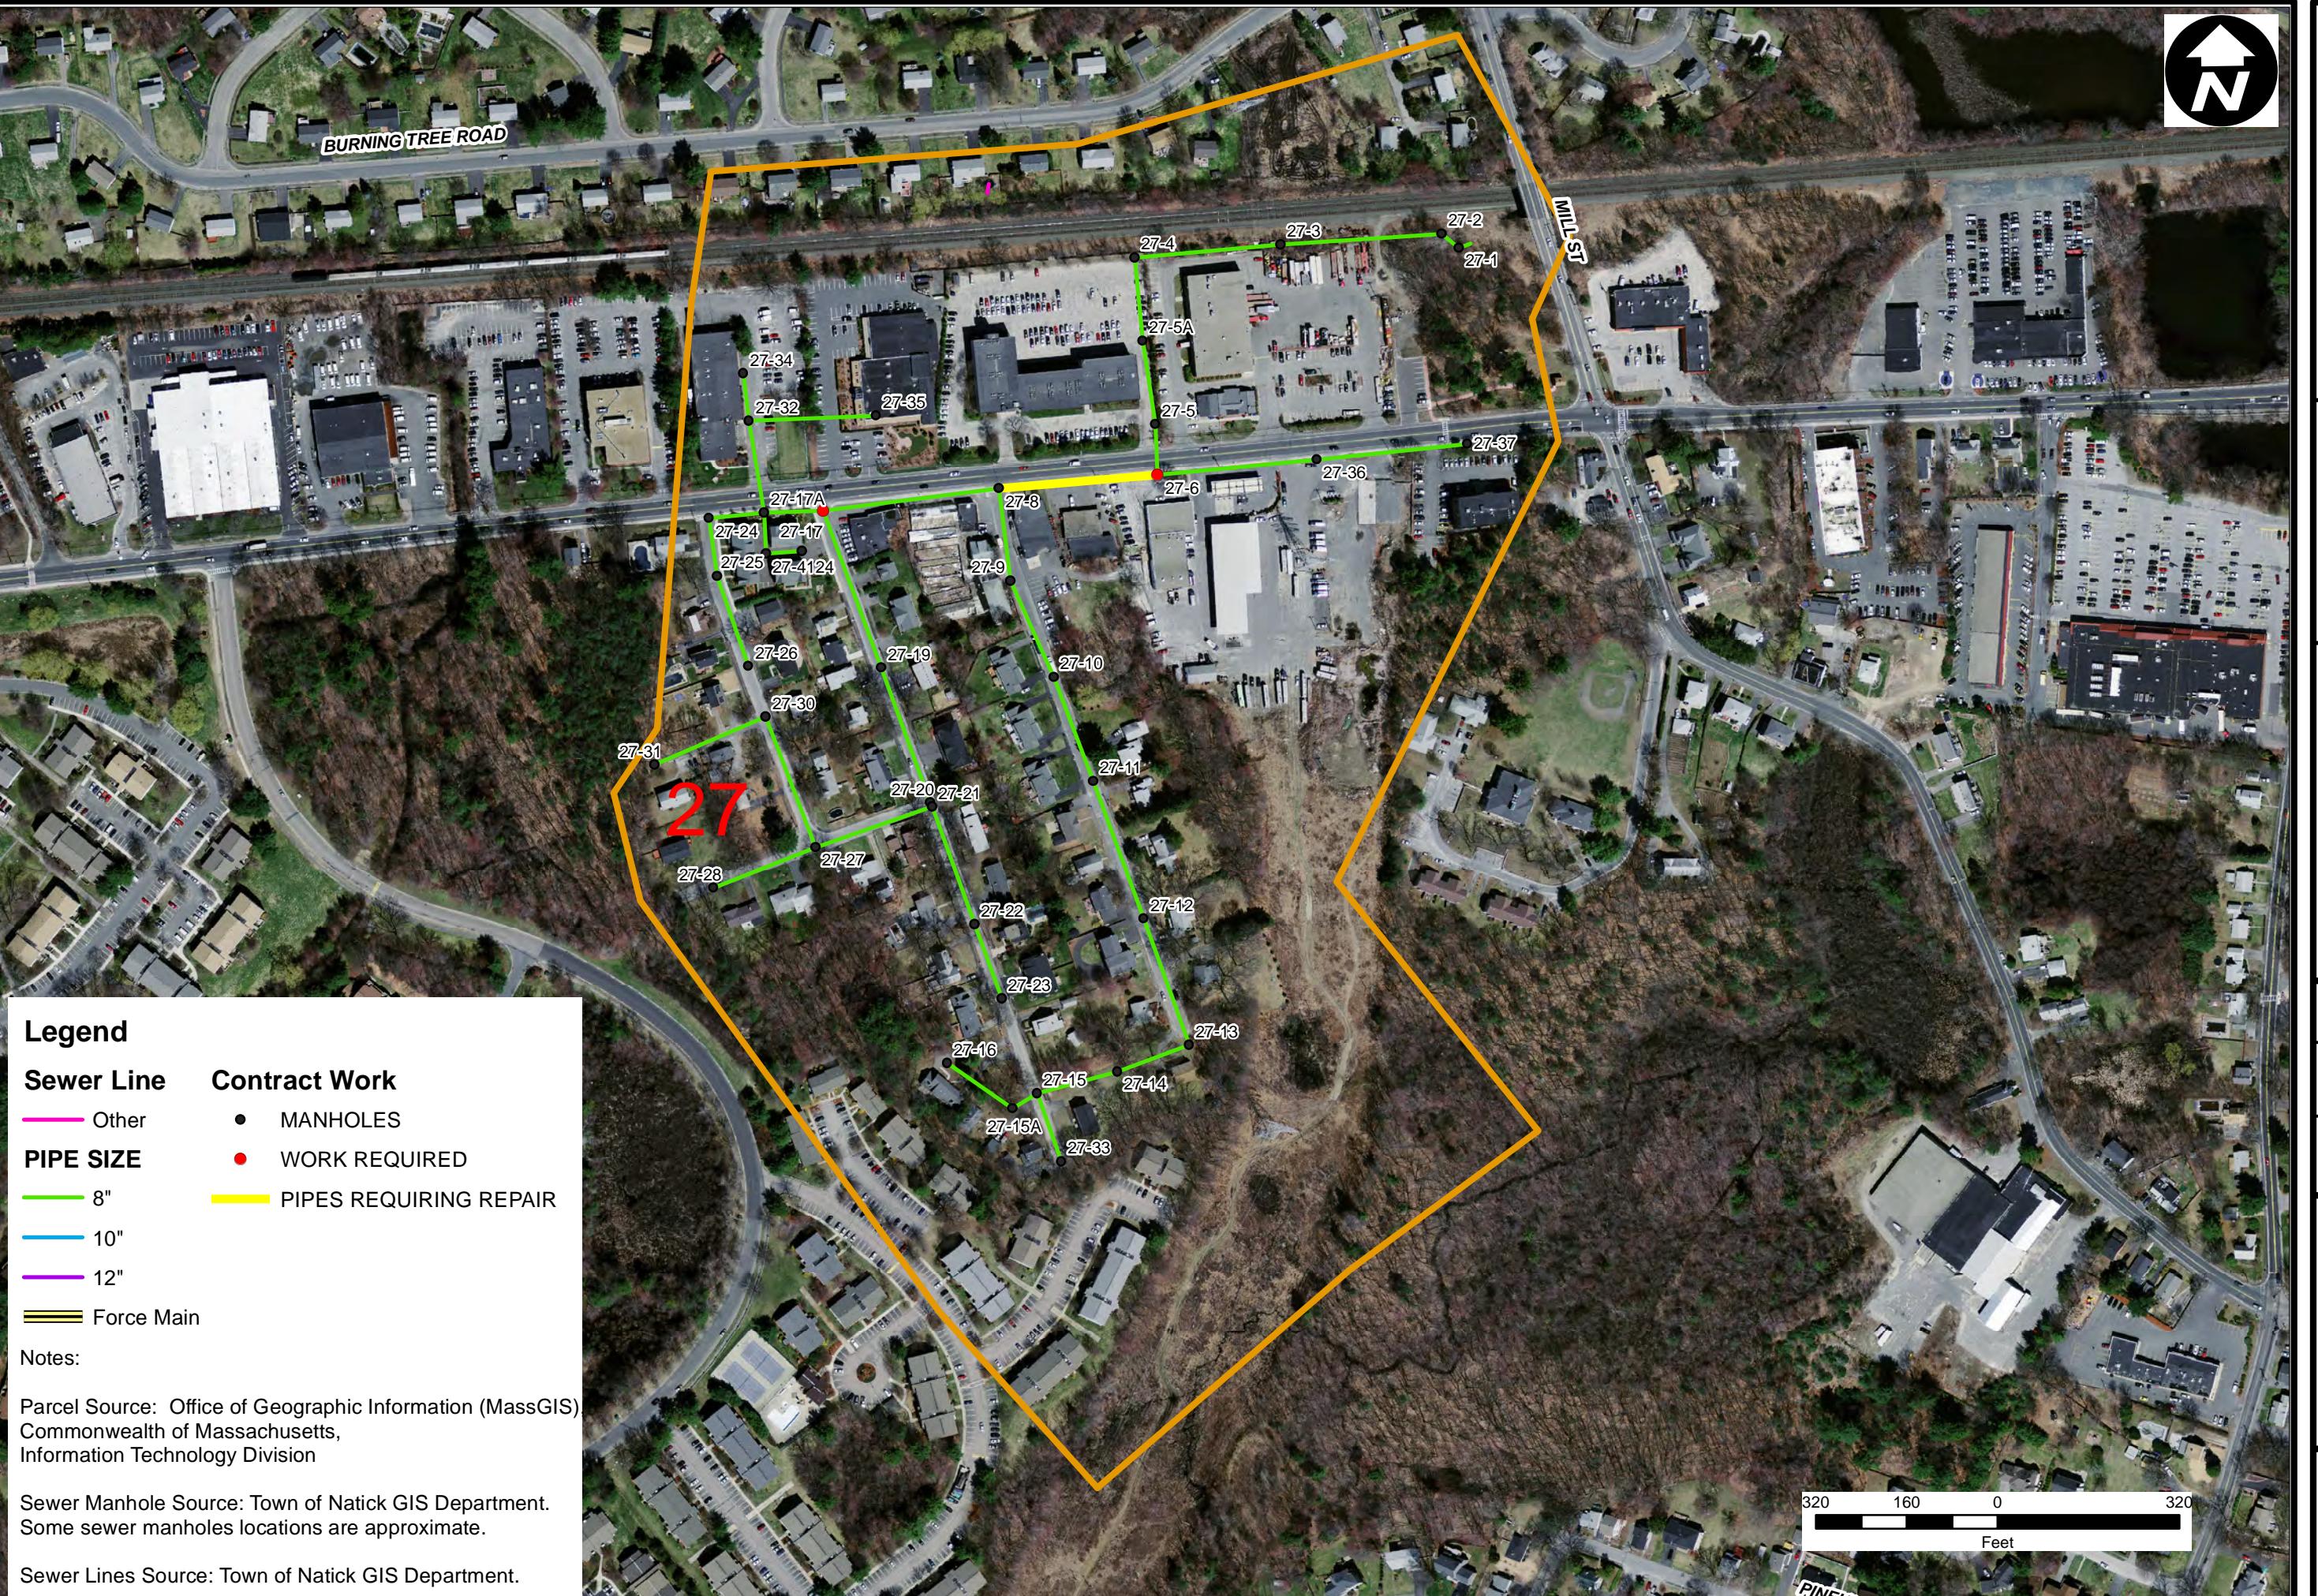

WEST CENTRAL ST.

HORIZONTAL SCALE 40 FEET TO AN INCH
VERTICAL SCALE 4 FEET TO AN INCH

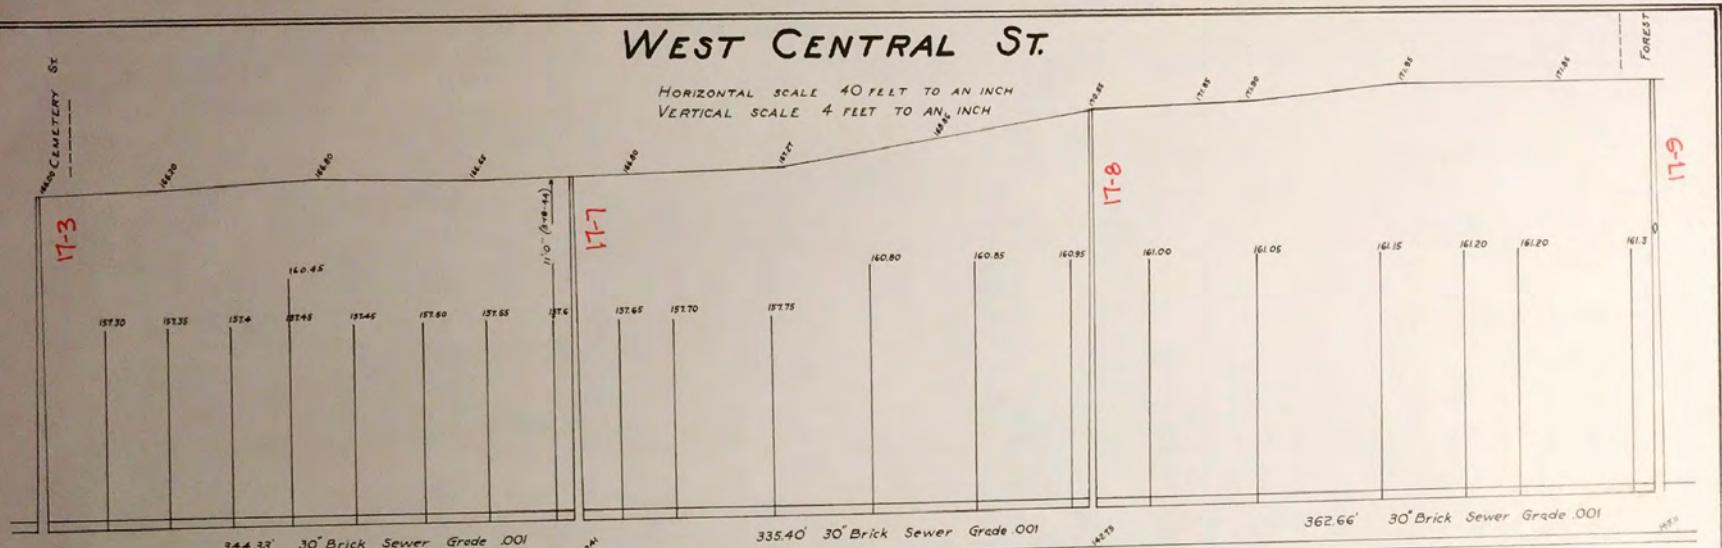


ELEV. 14

Sewer Relined 2001

Sewer Relined 2001


Sewer Relined 2001

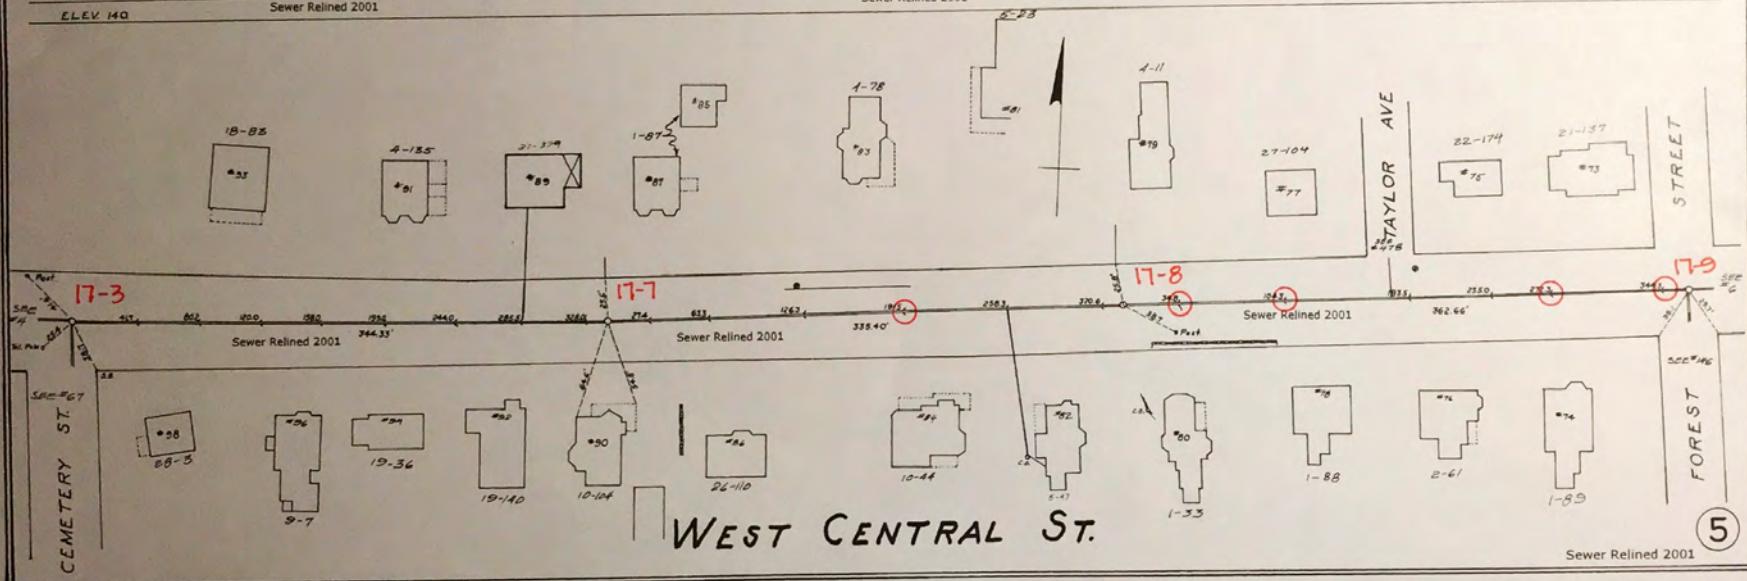

WEST CENTRAL ST.

17-9


HORIZONTAL SCALE 40 FEET TO AN INCH
VERTICAL SCALE 4 FEET TO AN INCH

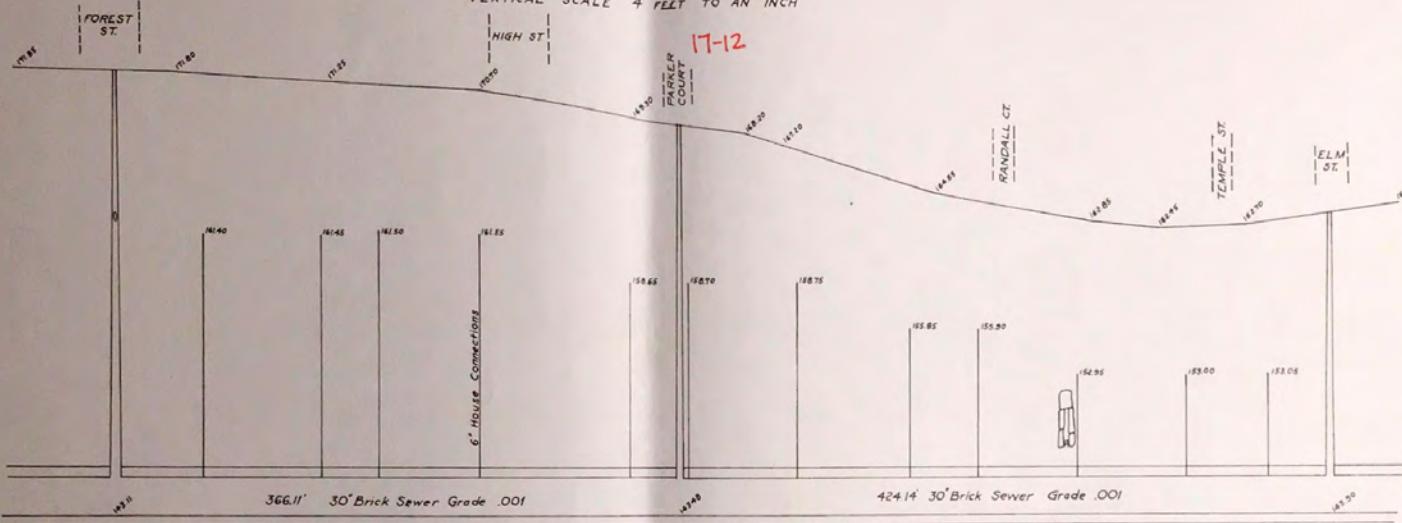

ELEV. 140.0



SEWER RELINED 2000

SEWER RELINED 2000


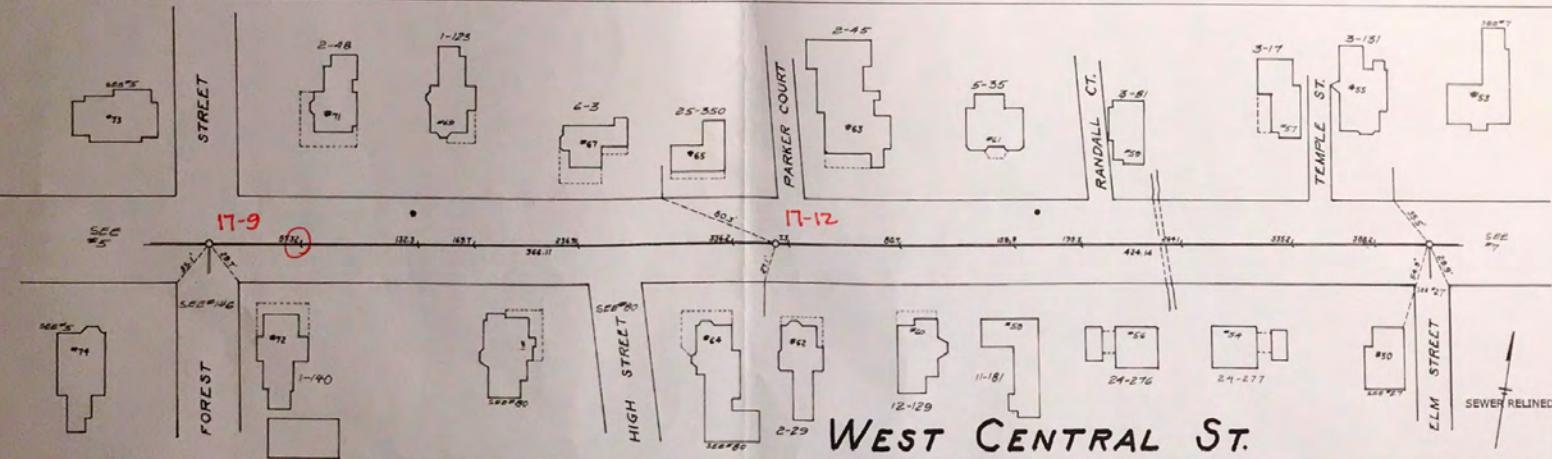


WEST CENTRAL ST.

⑥

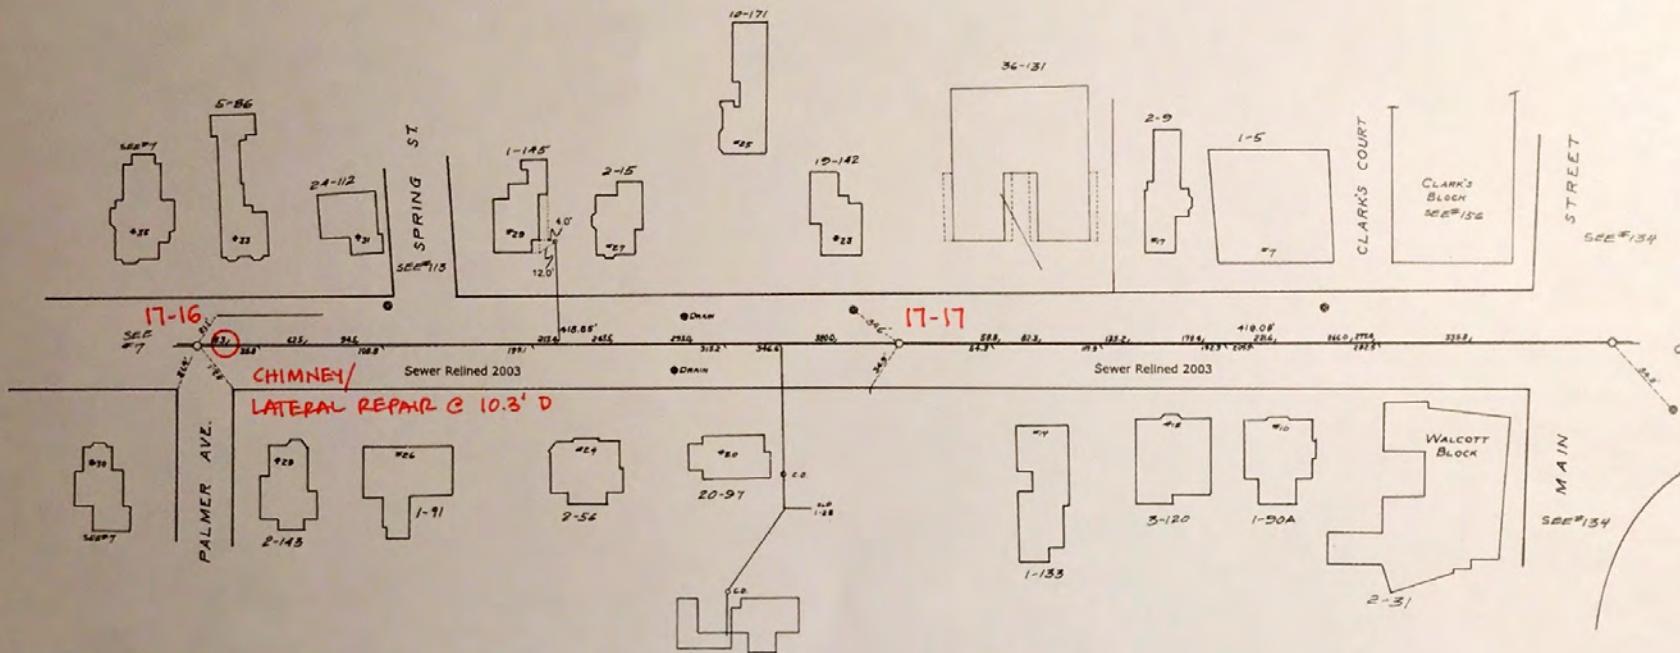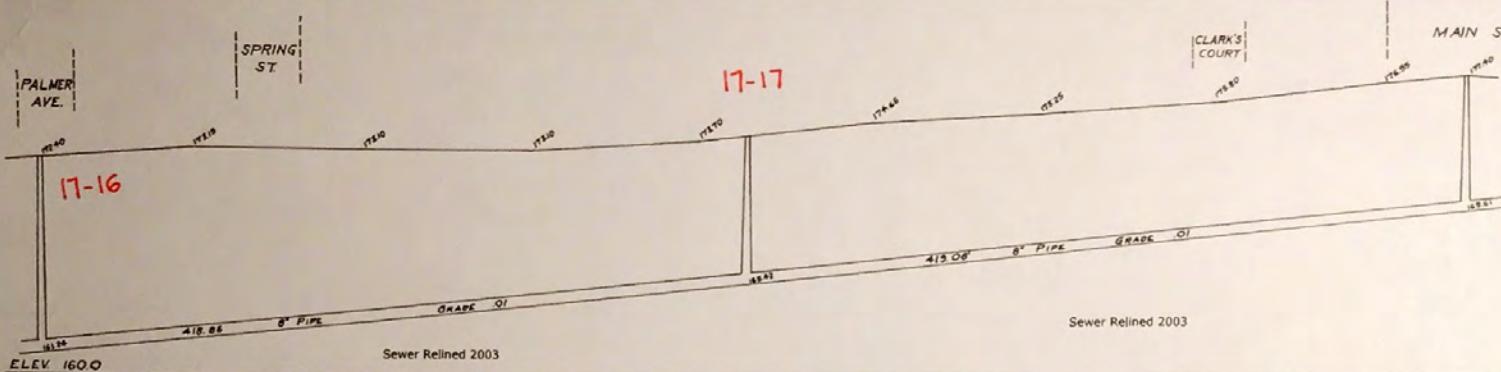


WEST CENTRAL ST.

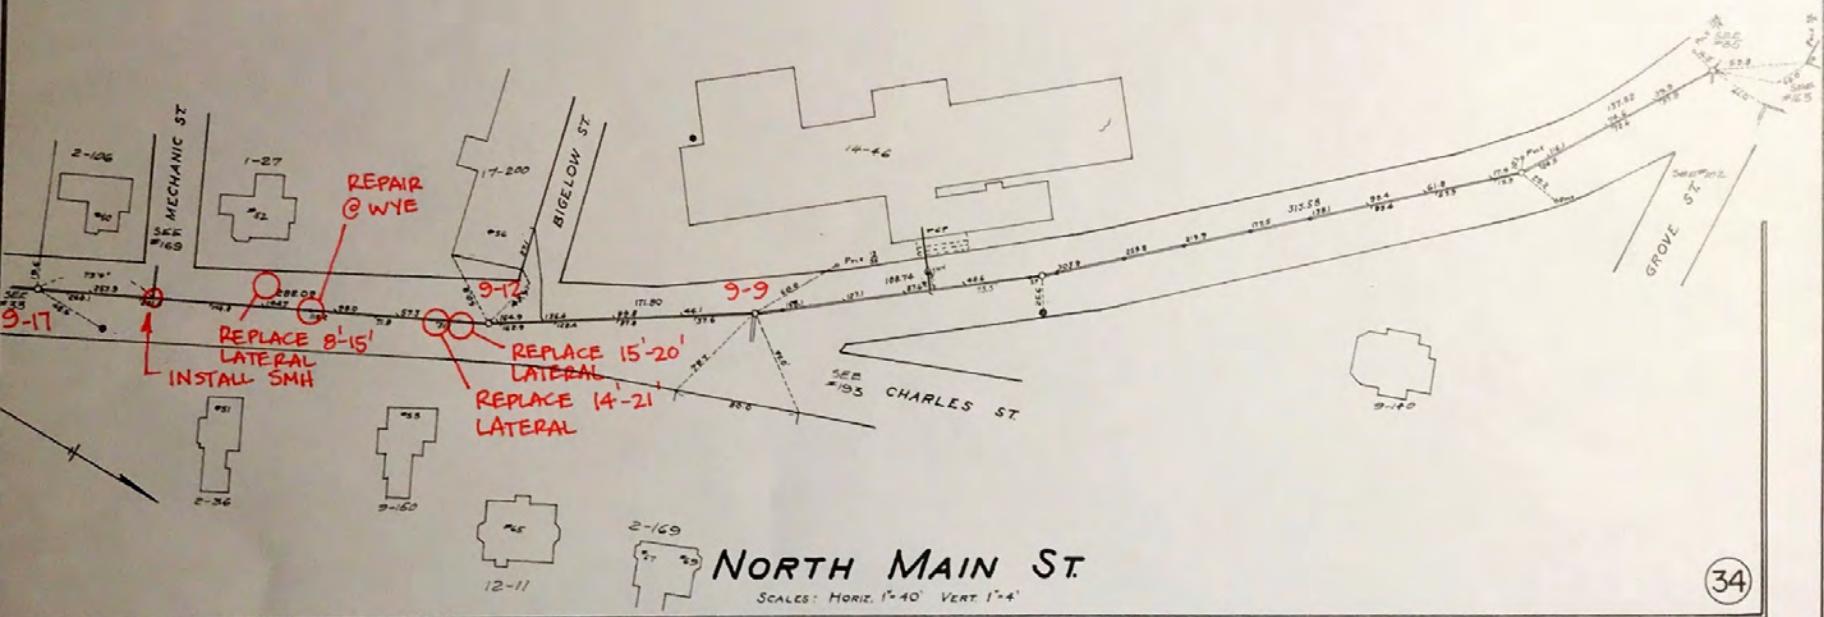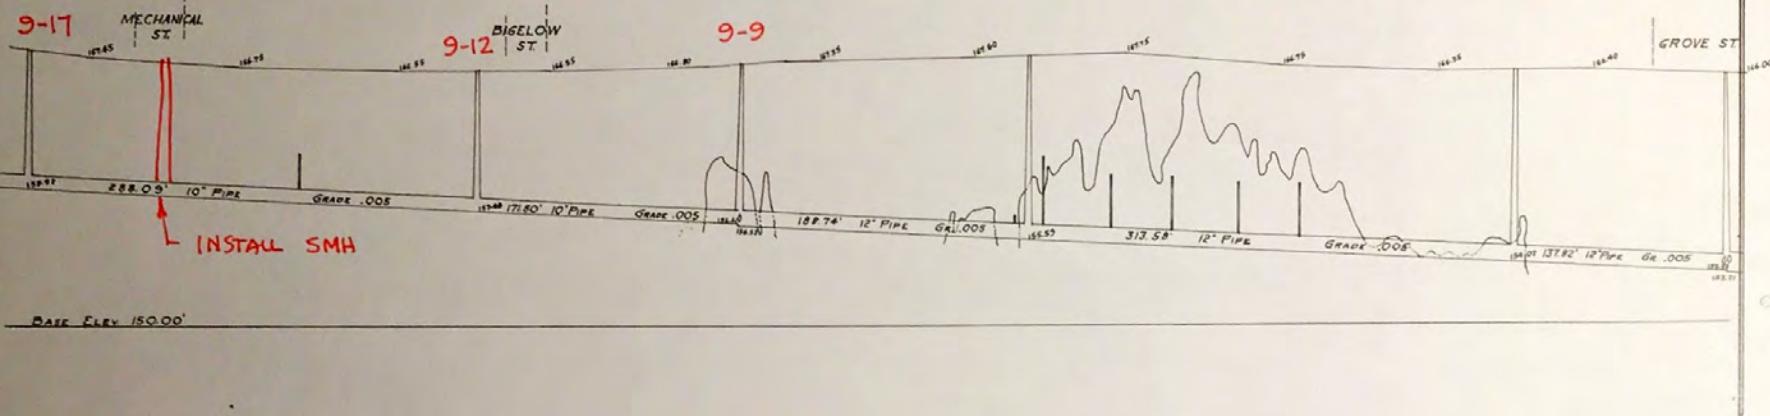



NORTH MAIN ST.

SCALES: HORIZ. 1"-40' VERT 1"-4'

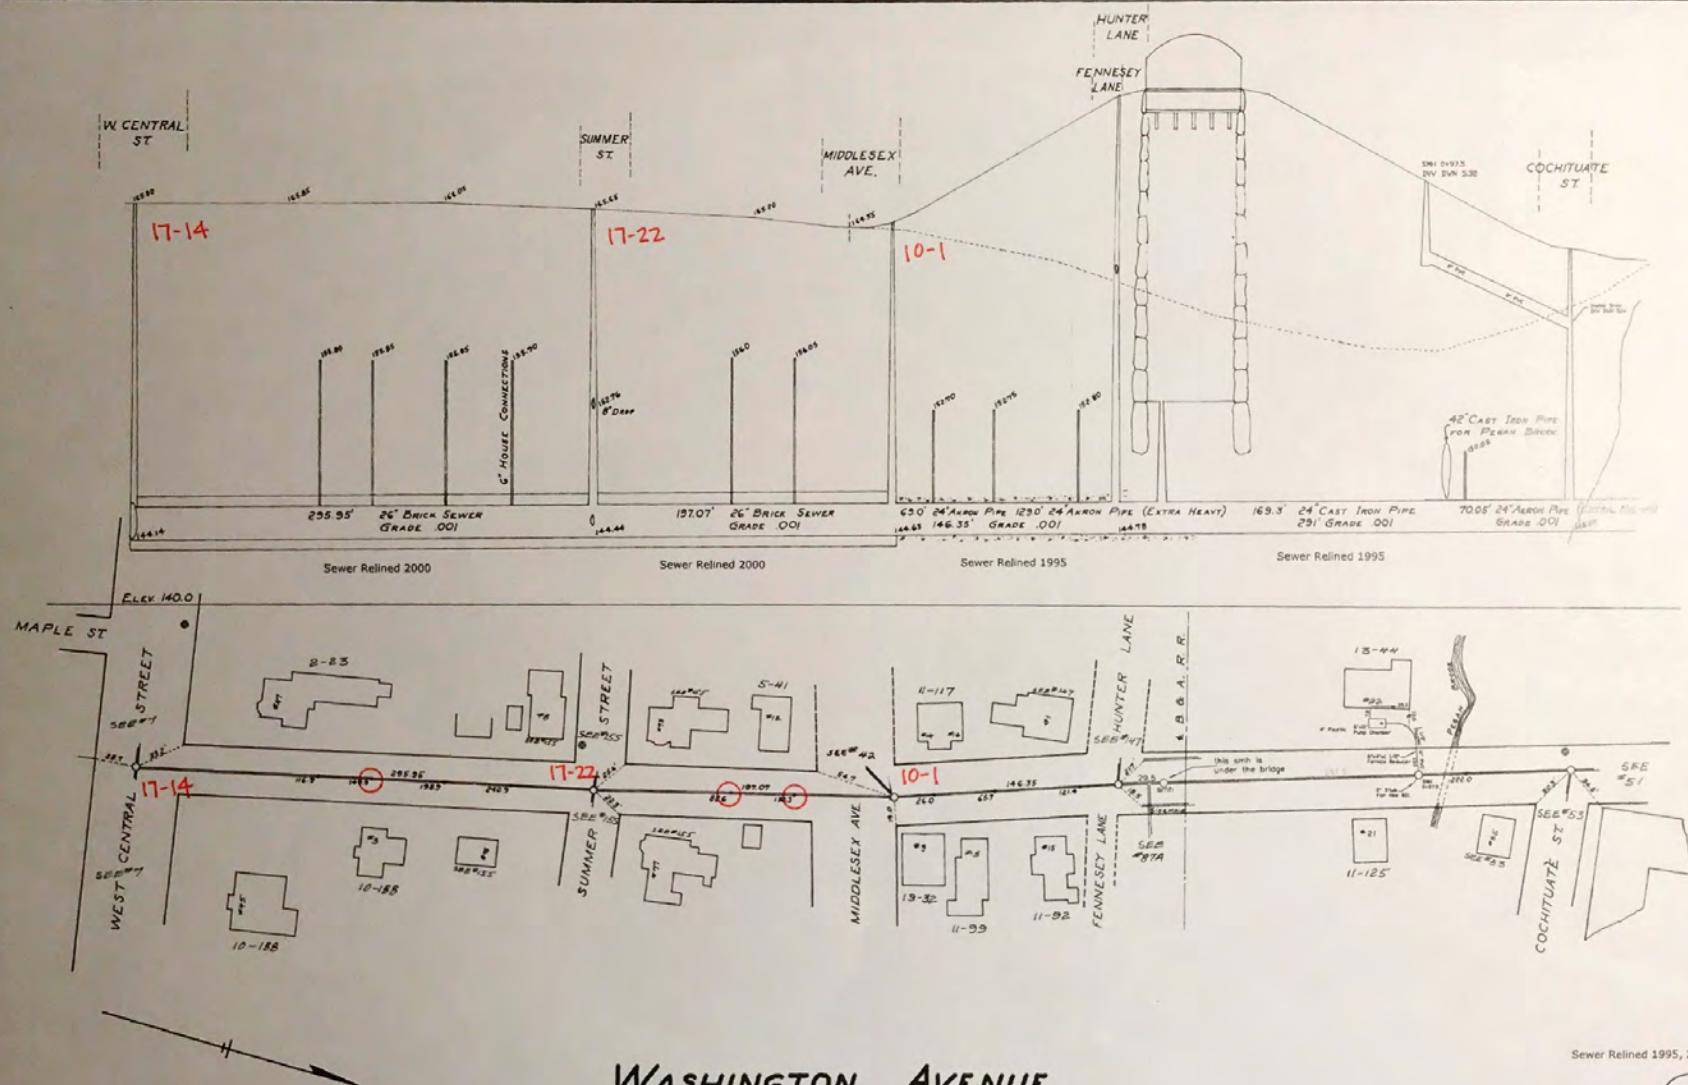



WASHINGTON AVENUE


SCALES: HORIZ 1" = 40' VERT 1" = 4'

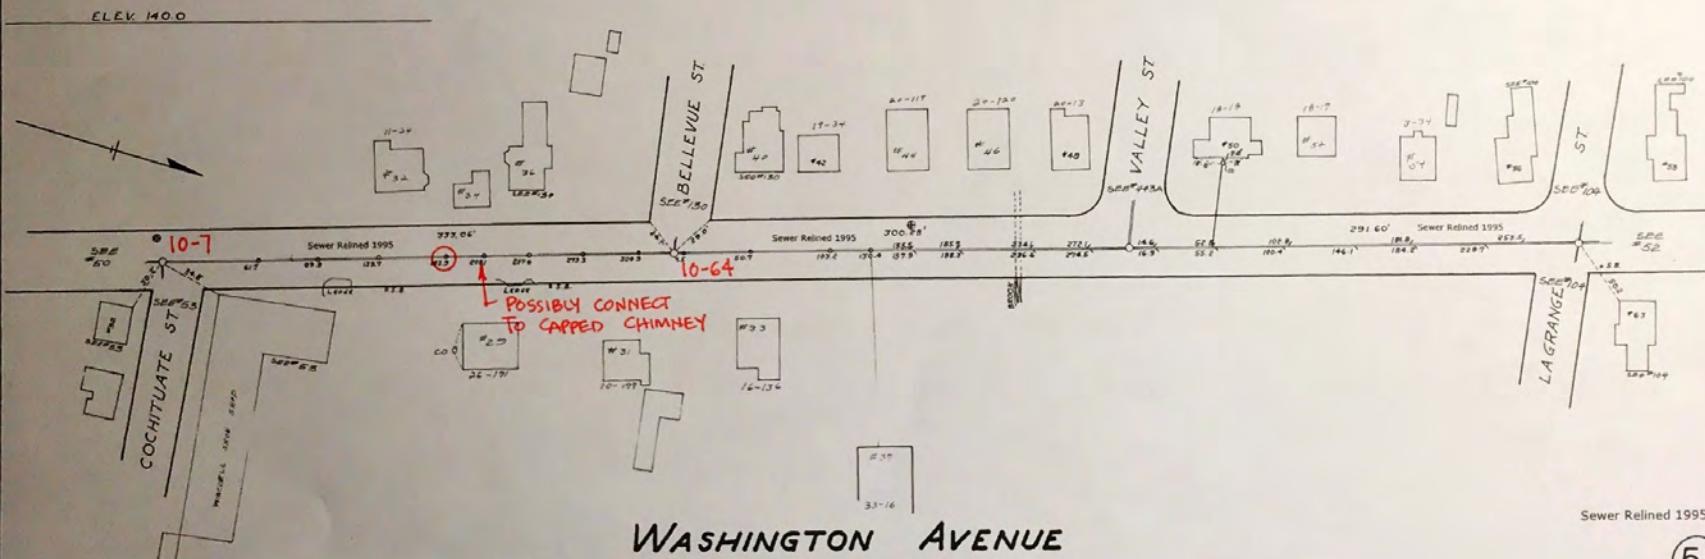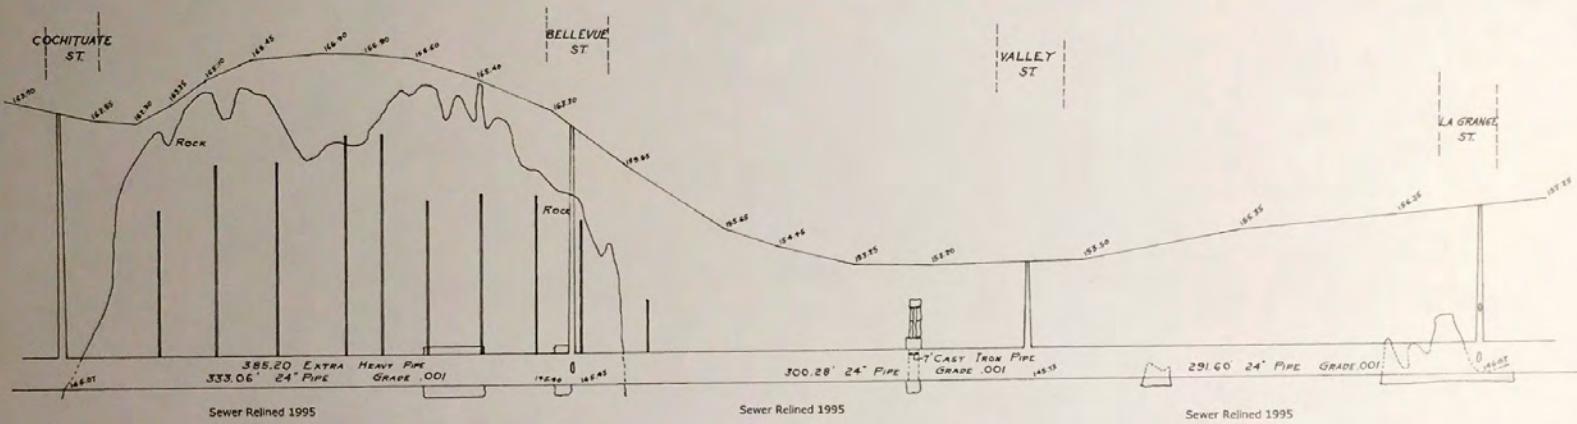


WASHINGTON AVENUE


SCALES: HORIZ $1'' = 40'$ VERT. $1'' = 4'$

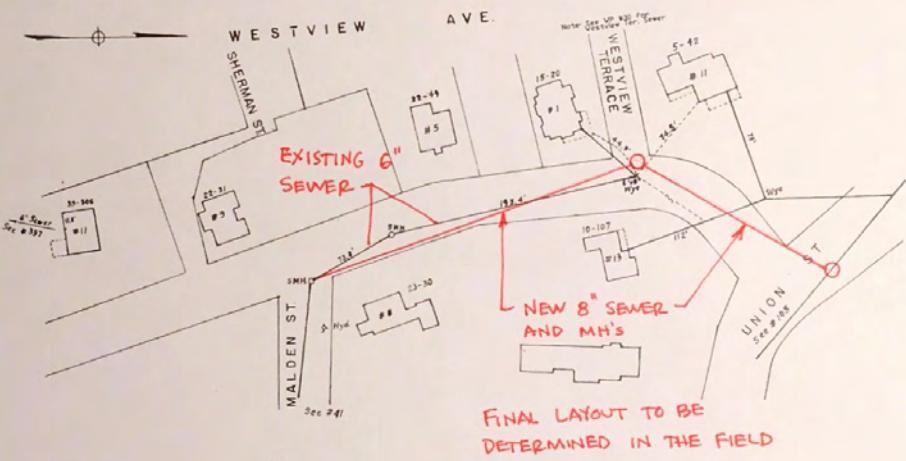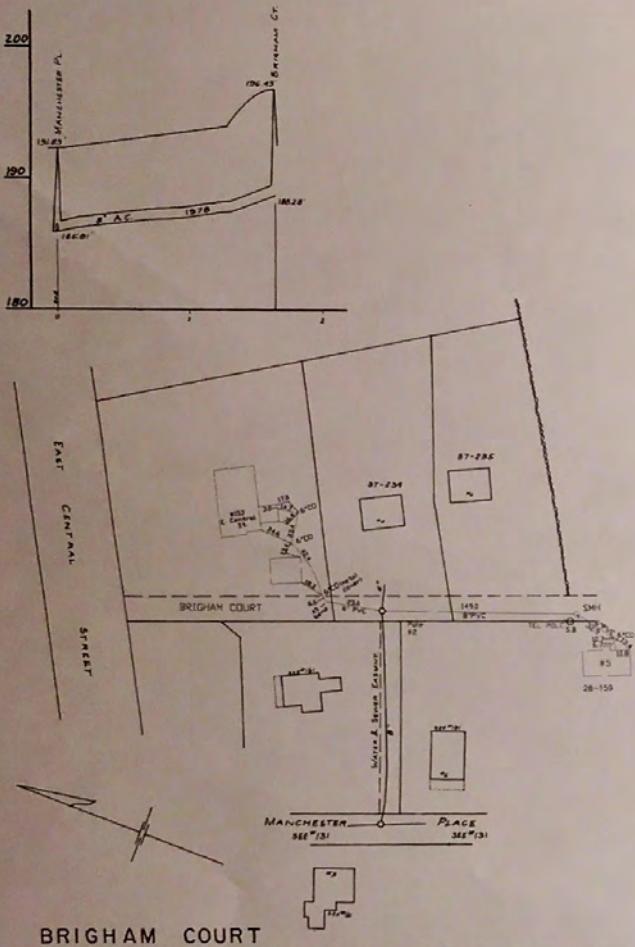


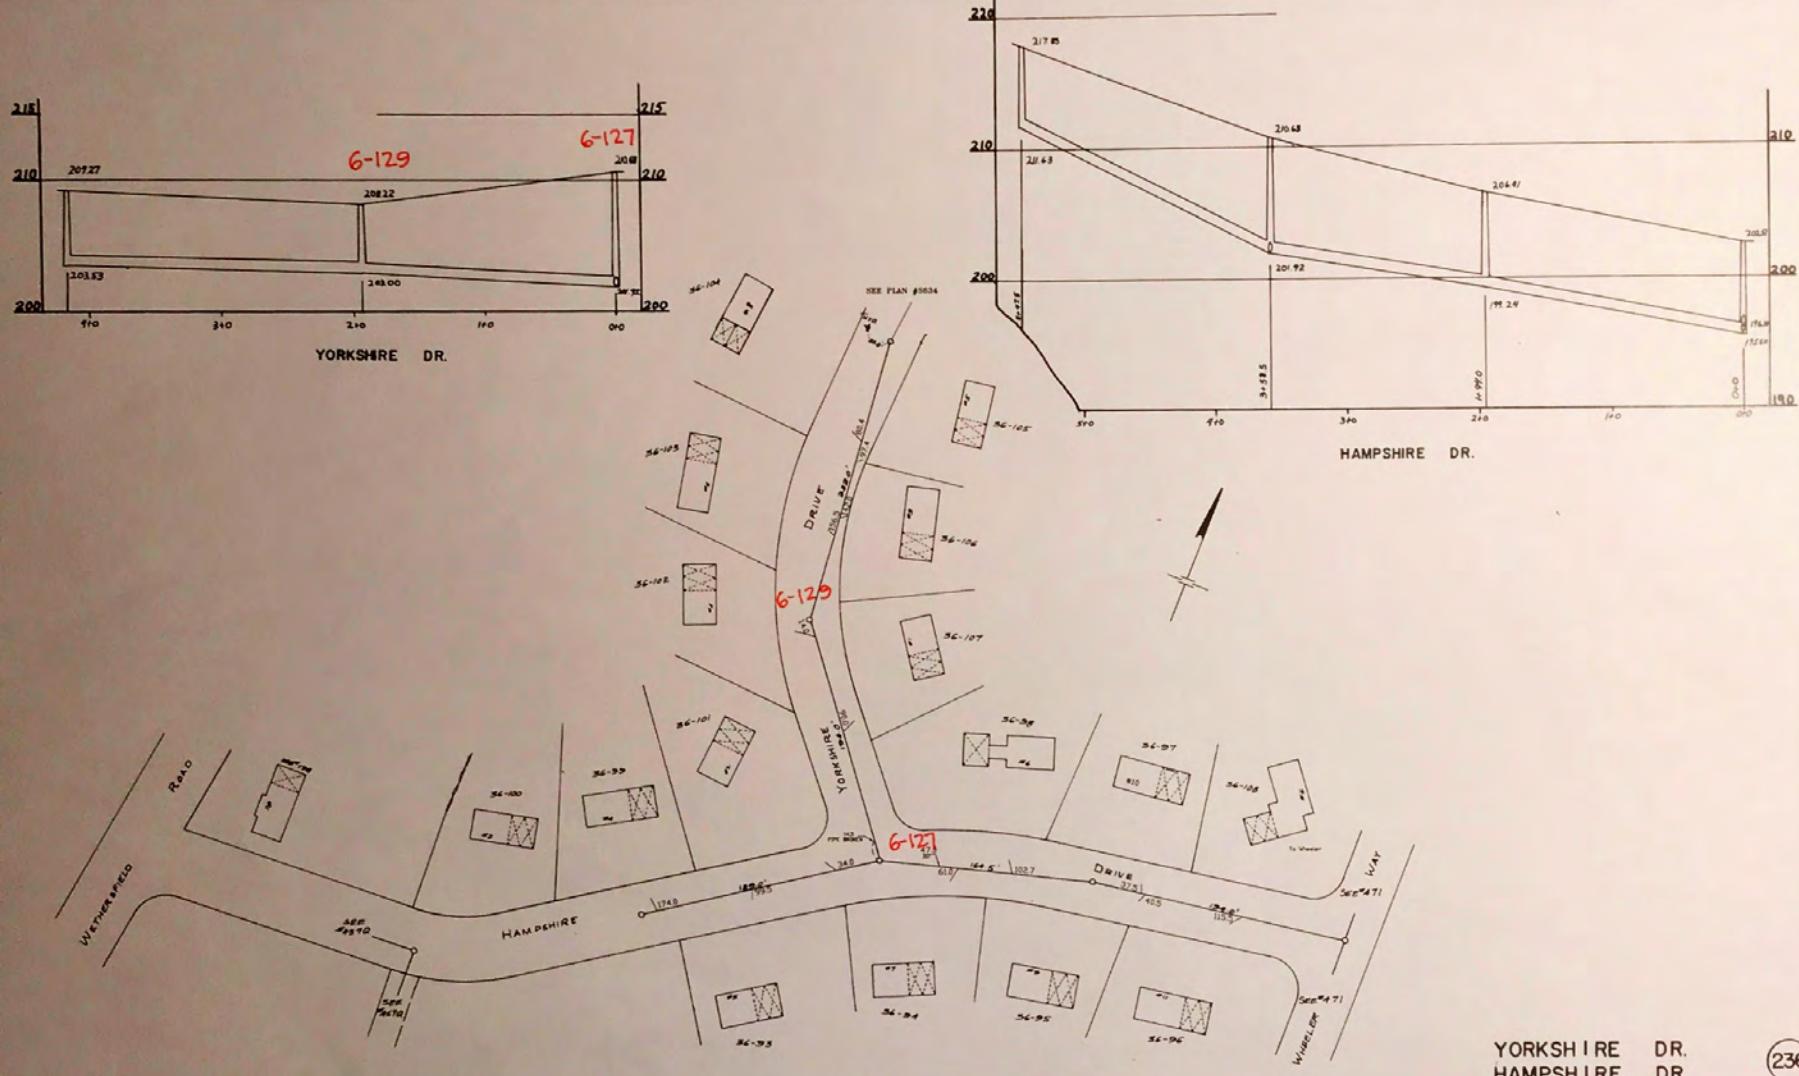

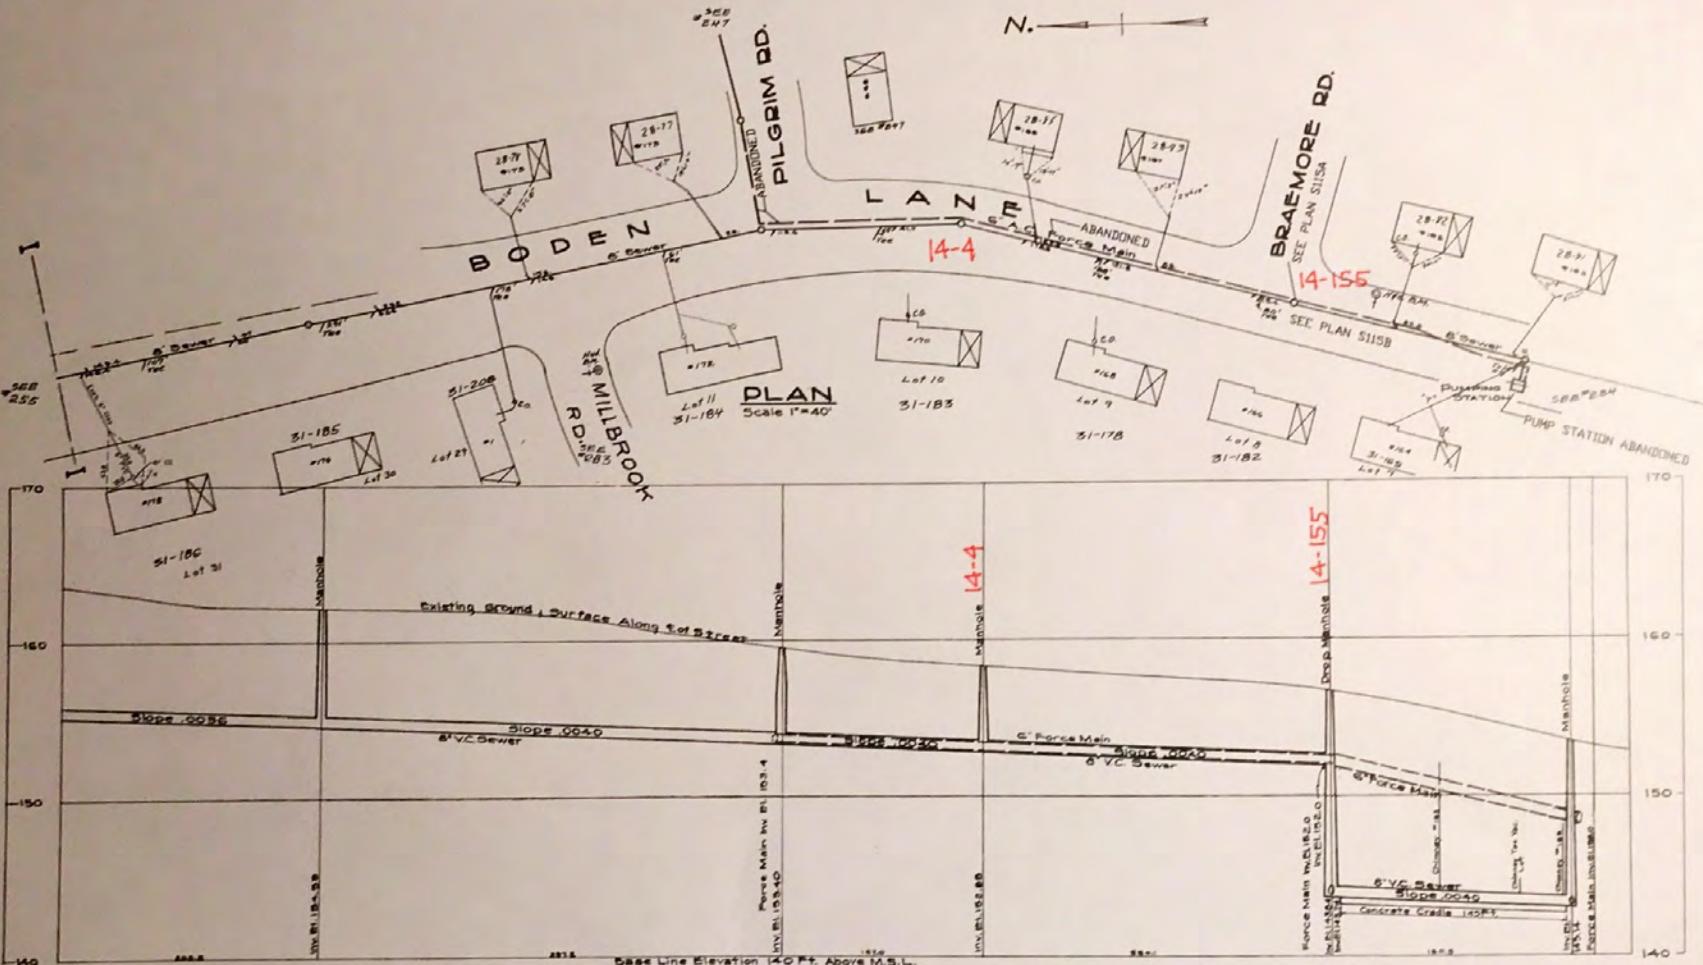

PROFILE

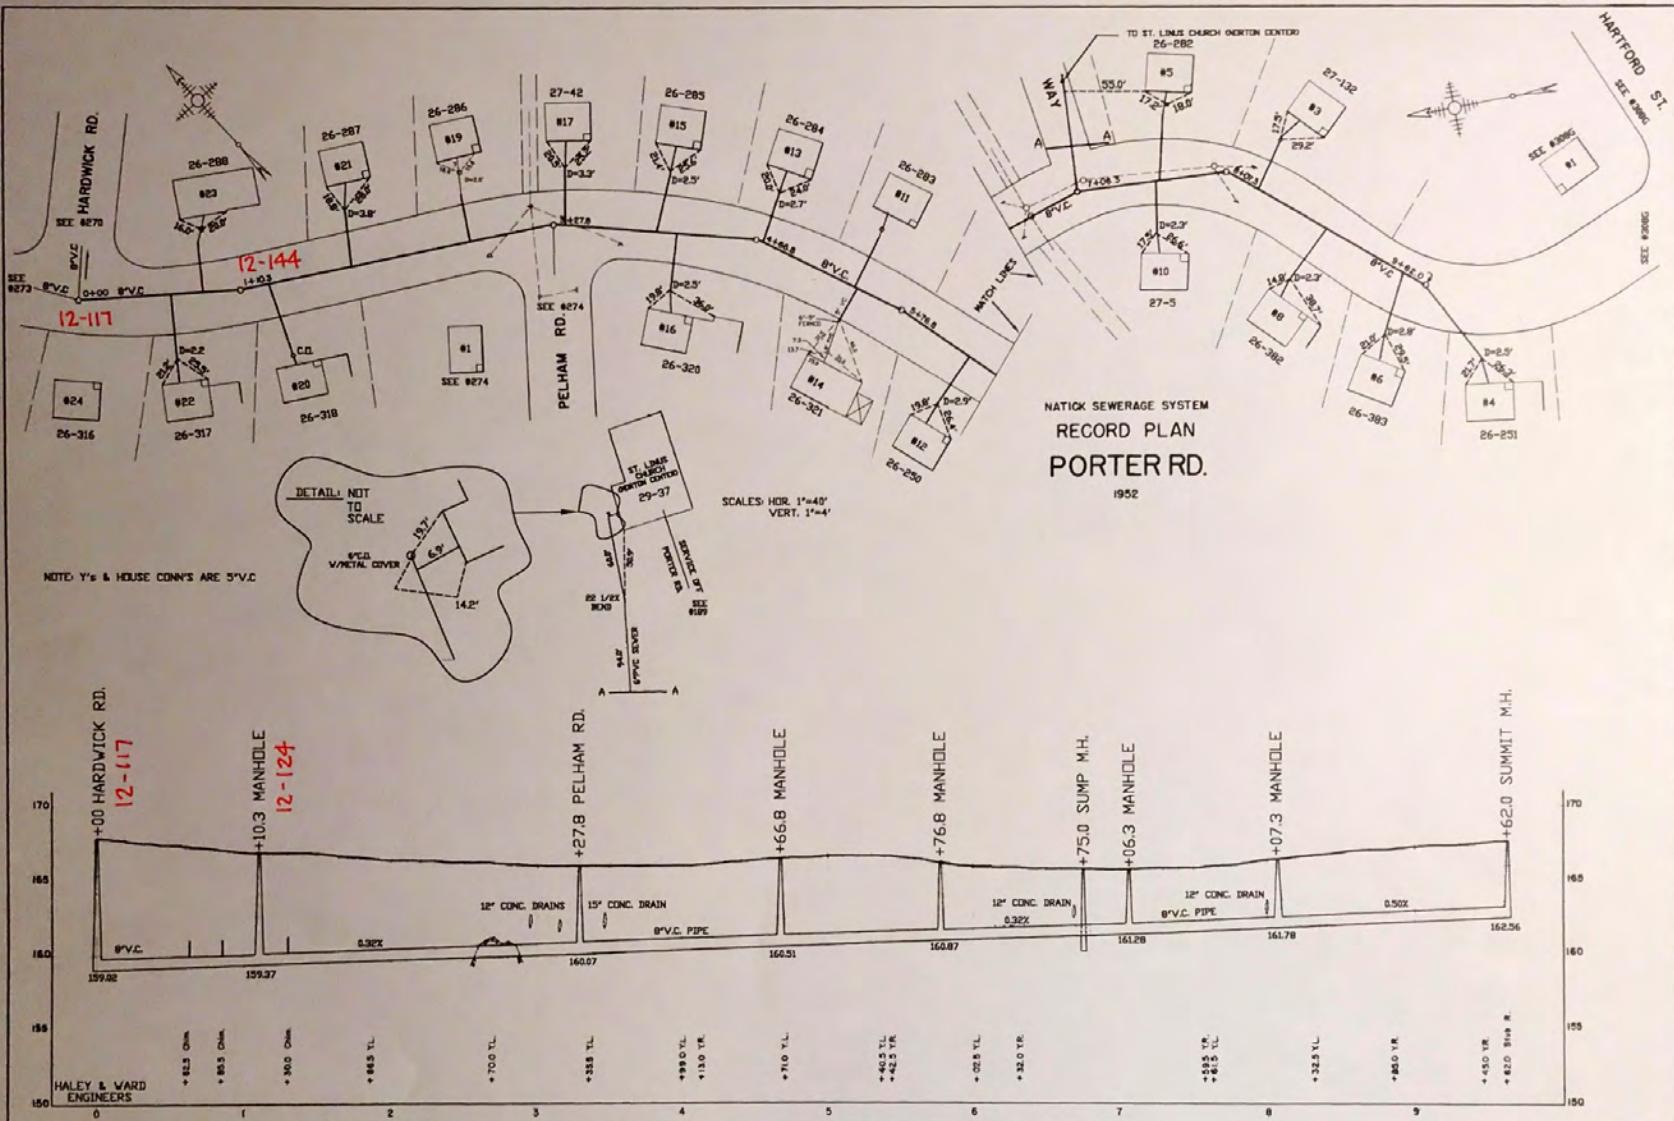

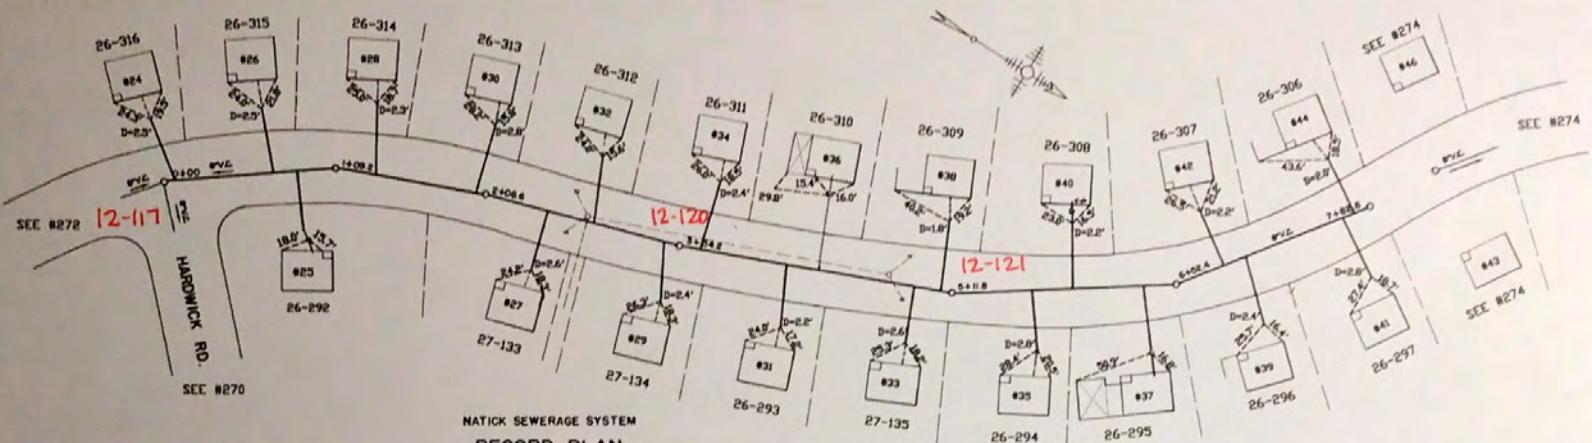



NATICK SEWERAGE SYSTEM
RECORD PLAN
PORTER RD.

1952

Scales: Hor. 1' = 40'
Vert. 1' = 20'

Note: Y's & House conn. are 5' V.C.

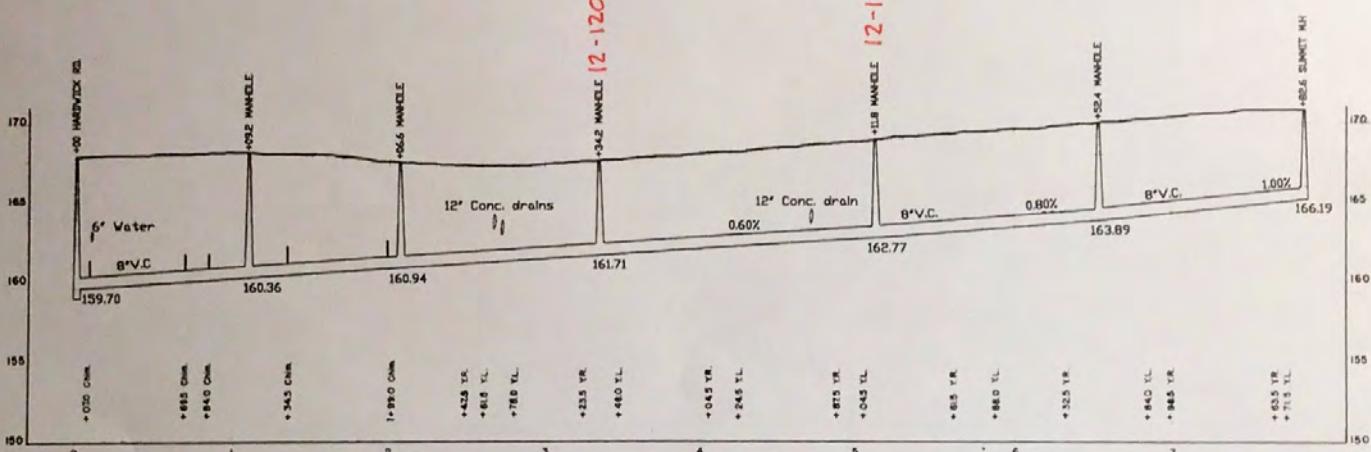

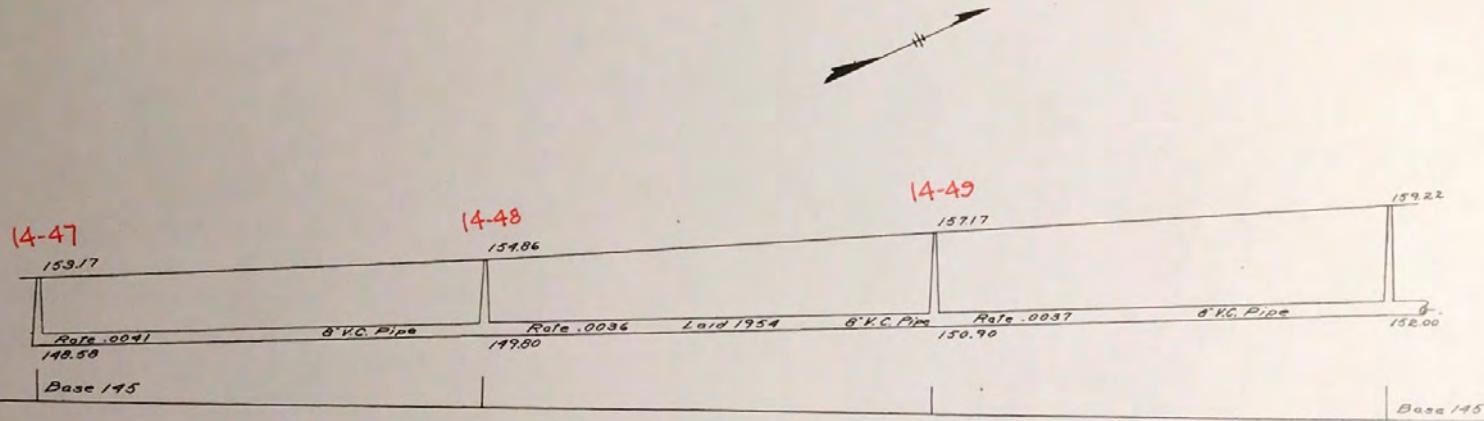



HEMLOCK DRIVE

Scales:

Hor. 1^o

— 707 —

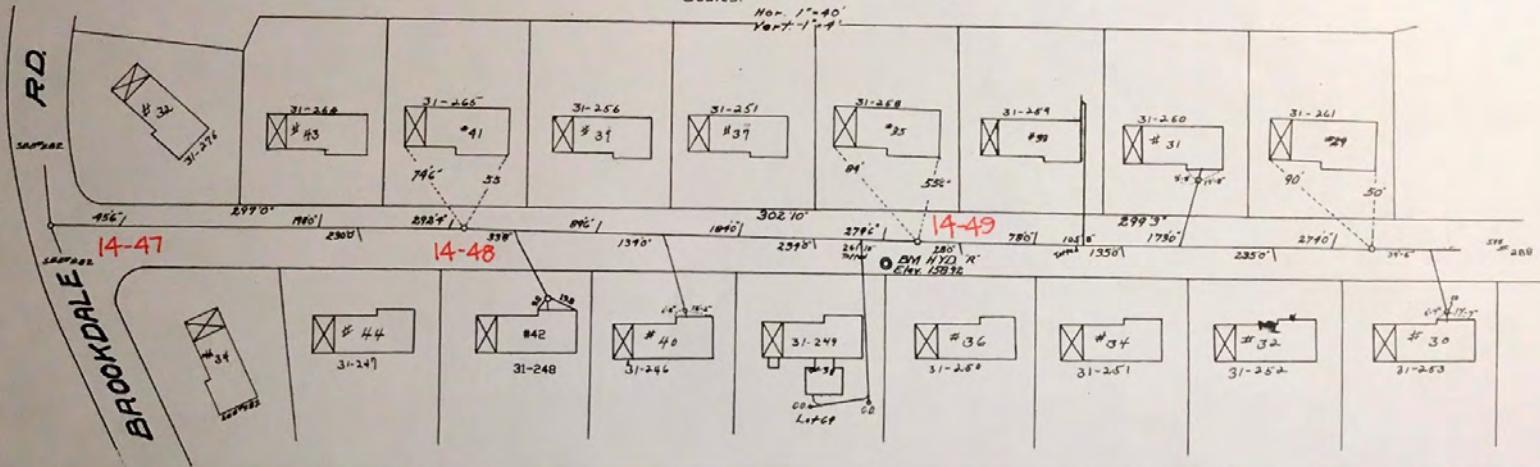

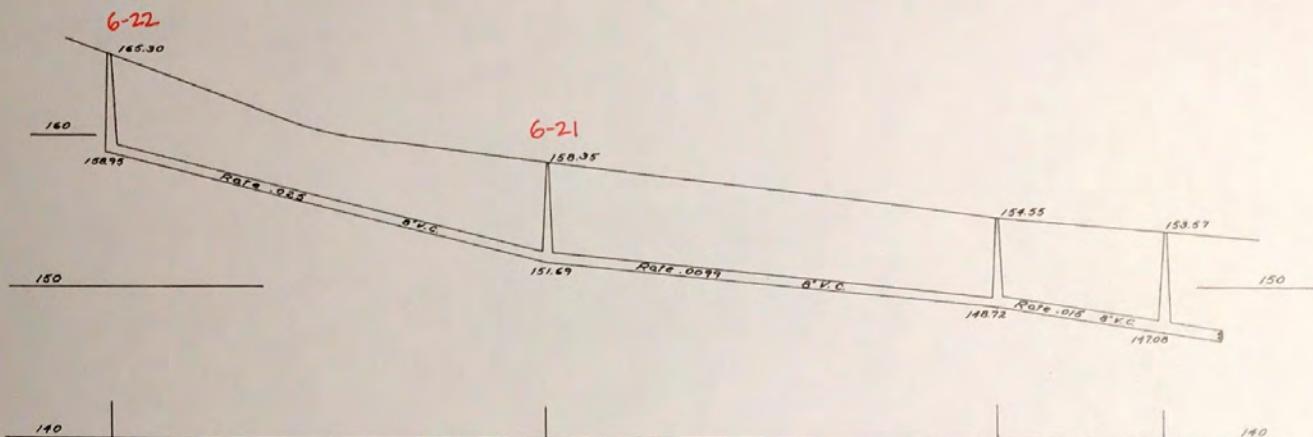

RICHARD RD.

Scales:
Hor. 1 in. = 40 ft.
Vert. 1 in. = 4 ft.

